


0908' 82-026


**LEGEND**

- NEW SYNTHETIC FIELD EXCAVATE 12" DEPTH OF AS REQUIRED & INSTALL NEW SYNTHETIC TURF  
CONTRACT NB - LC - 0553.1
- DEMOLISH EXISTING FENCE AND PROVIDE NEW 4' HIGH CHAIN LINK FENCE  
CONTRACT NB - LC - 0553.1
- NOTES: CONTRACT LC 0553.1  
HYDRO SEED ALL NATURAL GRASS AREAS DISTURBED BY CONSTRUCTION
- EXISTING ASPHALT TRACK SURFACE WITH EXISTING RUBBER SURFACING REMOVE EXISTING SURFACING POWER WASH PRIOR TO INSTALLING NEW RUBBER SURFACING  
CONTRACT NB - LC - 0553.2
- SAW CUT EDGE OF EXISTING TRACK REMOVE ASPHALT AND EXCAVATE TO A DEPTH OF 42" INSTALL 36" OF 3" CRUSHED STONE COMPACTED TO 95% OF DENSITY. INSTALL 6" OF 3/4" CRUSHED STONE PAVING AND 2 LAYERS 1-1/2" LIFTS TO MATCH EXISTING TRACK. (1200 SQUARE FEET)  
CONTRACT NB - LC - 0553.2
- NOTES: CONTRACT LC 0553.2  
ASPHALT CRACKS AFTER REMOVAL OF EXISTING RUBBER ALL CRACKS LARGER THAN 3/4" SHALL BE FILLED WITH HOT POUR RUBBERIZED ASPHALT, CALIFORNIA PRODUCTS COURT PATCH BINDER OR OTHER SUITABLE MATERIAL AS APPROVED BY THE ENGINEER. ASSUME 250 LB OF CRACK FILLING WORK. TRACK RESURFACING SHALL OCCUR WHILE SCHOOL IS OUT OF SESSION.
- ALL ELEVATIONS RELATIVE

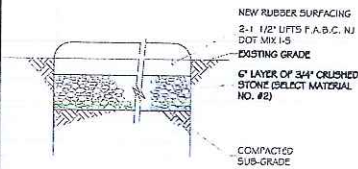



**TRACK AND LONG JUMP RUNWAY REPAIR**  
SCALE: 1" = 1'-0"

CONTRACT LC 0553.2

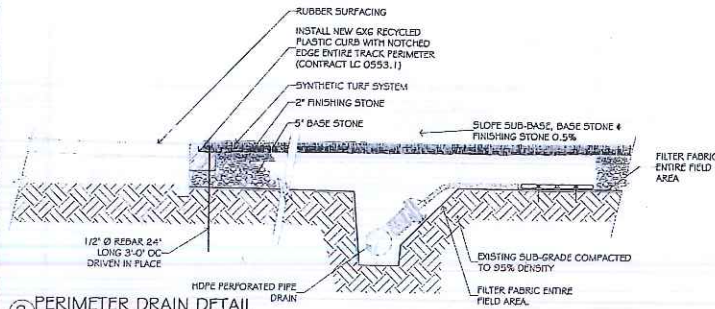

**PERIMETER DRAIN DETAIL**  
SCALE: 3/4" = 1'-0"

CONTRACT LC 0553.1

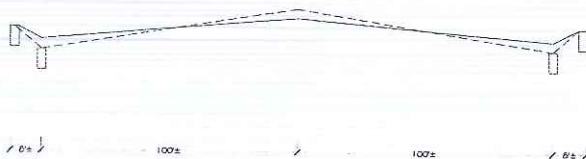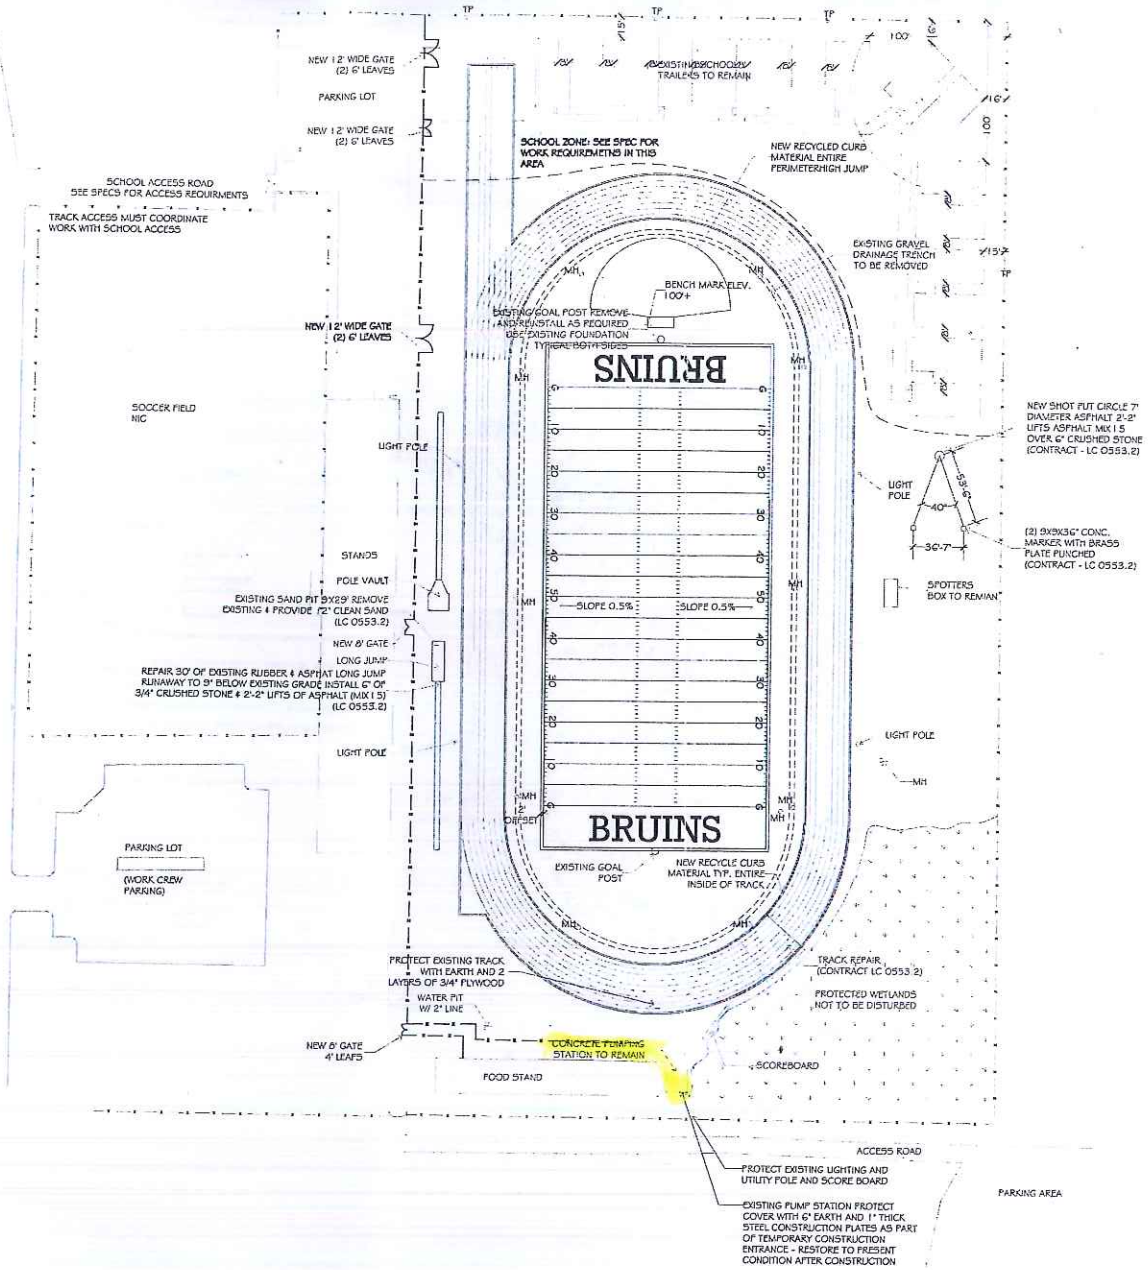

DESIGNED BY	JC	DATE	11/18/02	
DRAWN BY	AO	DATE	11/18/02	
CHECKED BY	GL	DATE	11/18/02	
SCALE	1" = 50'			
NO.	DATE	DRAWN	CHECKED	DESCRIPTION
2	11-19-09	JC		RECORD DRAWING
1	11/18/02	AO	JC	BID SET

**L+C DESIGN CONSULTANTS PA**

ARCHITECTURE ENGINEERING PLANNING  
333 Meadowland Parkway Secaucus, New Jersey 07094

JOHN CURRY PE

N.J. LIC. NO. 34706

**SITE PLAN/GRADING PLAN**

**NORTH HUDSON PARK STADIUM  
TRACK AND FIELD GREEN ACRES GRANT  
TOWNSHIP OF NORTH BERGEN**

**SP-1**

LC 0553