


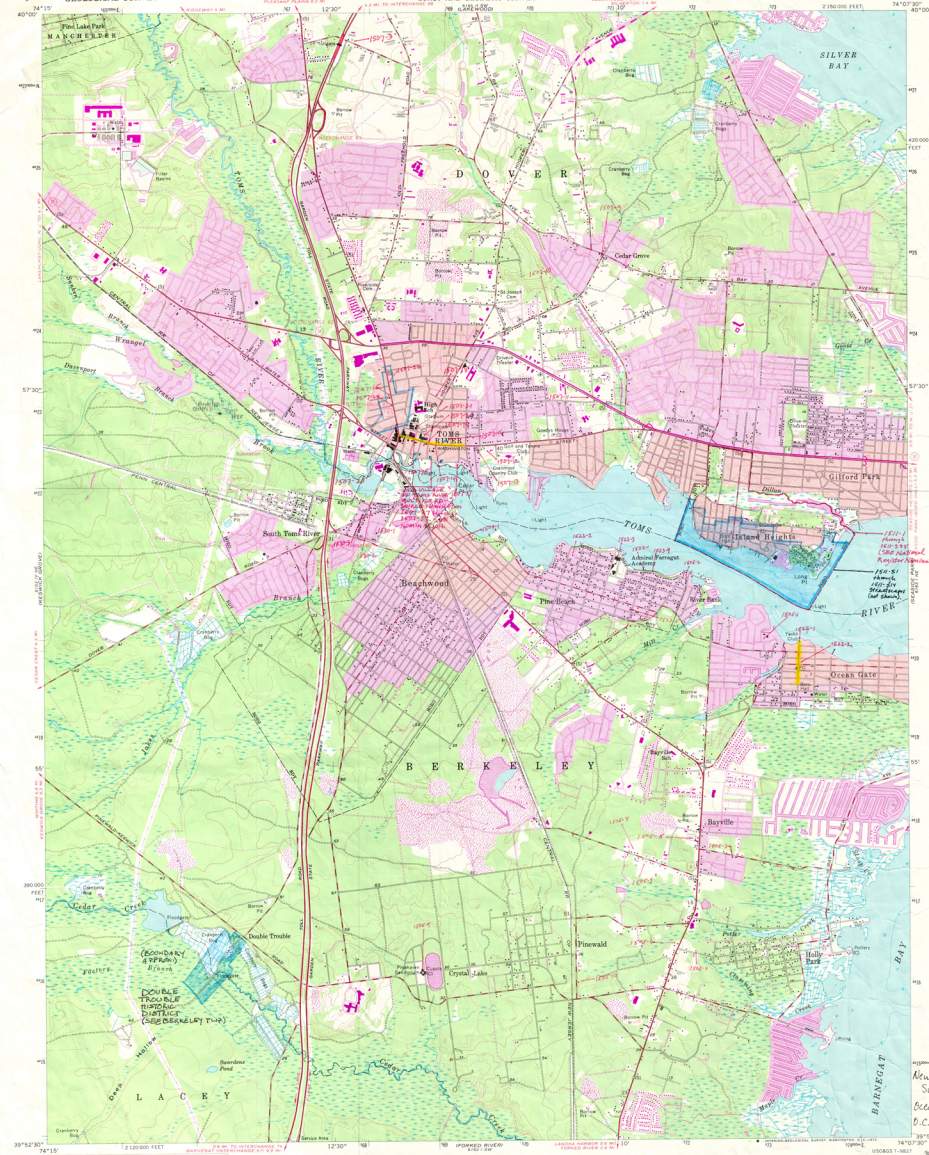


OCEAN COUNTY HISTORIC SITES SURVEY 1980-81

- Municipal code and historic site form
- National Register site or pending nomination
- Proposed future historic district
- Streetscape form

Red line indicates areas in which only historic buildings are shown. Unchecked elevations are shown in brown. Ocean Gate borough boundary in Toms River is the water line.

shown in purple compiled by the Geological Survey from aerial photography taken 1970. This purple line indicates extension of urban areas.

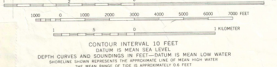


- ROAD CLASSIFICATION
- Heavy-duty
  - Light-duty
  - Unimproved
  - U.S. Route
  - State Route

TOMS RIVER, N.J.  
1983  
PHOTOGRAPHIC 1970  
AND 1971 7.5-MINUTE SERIES

New Jersey Historic Sites Inventory Ocean County Survey O.C.C. #C-1981