
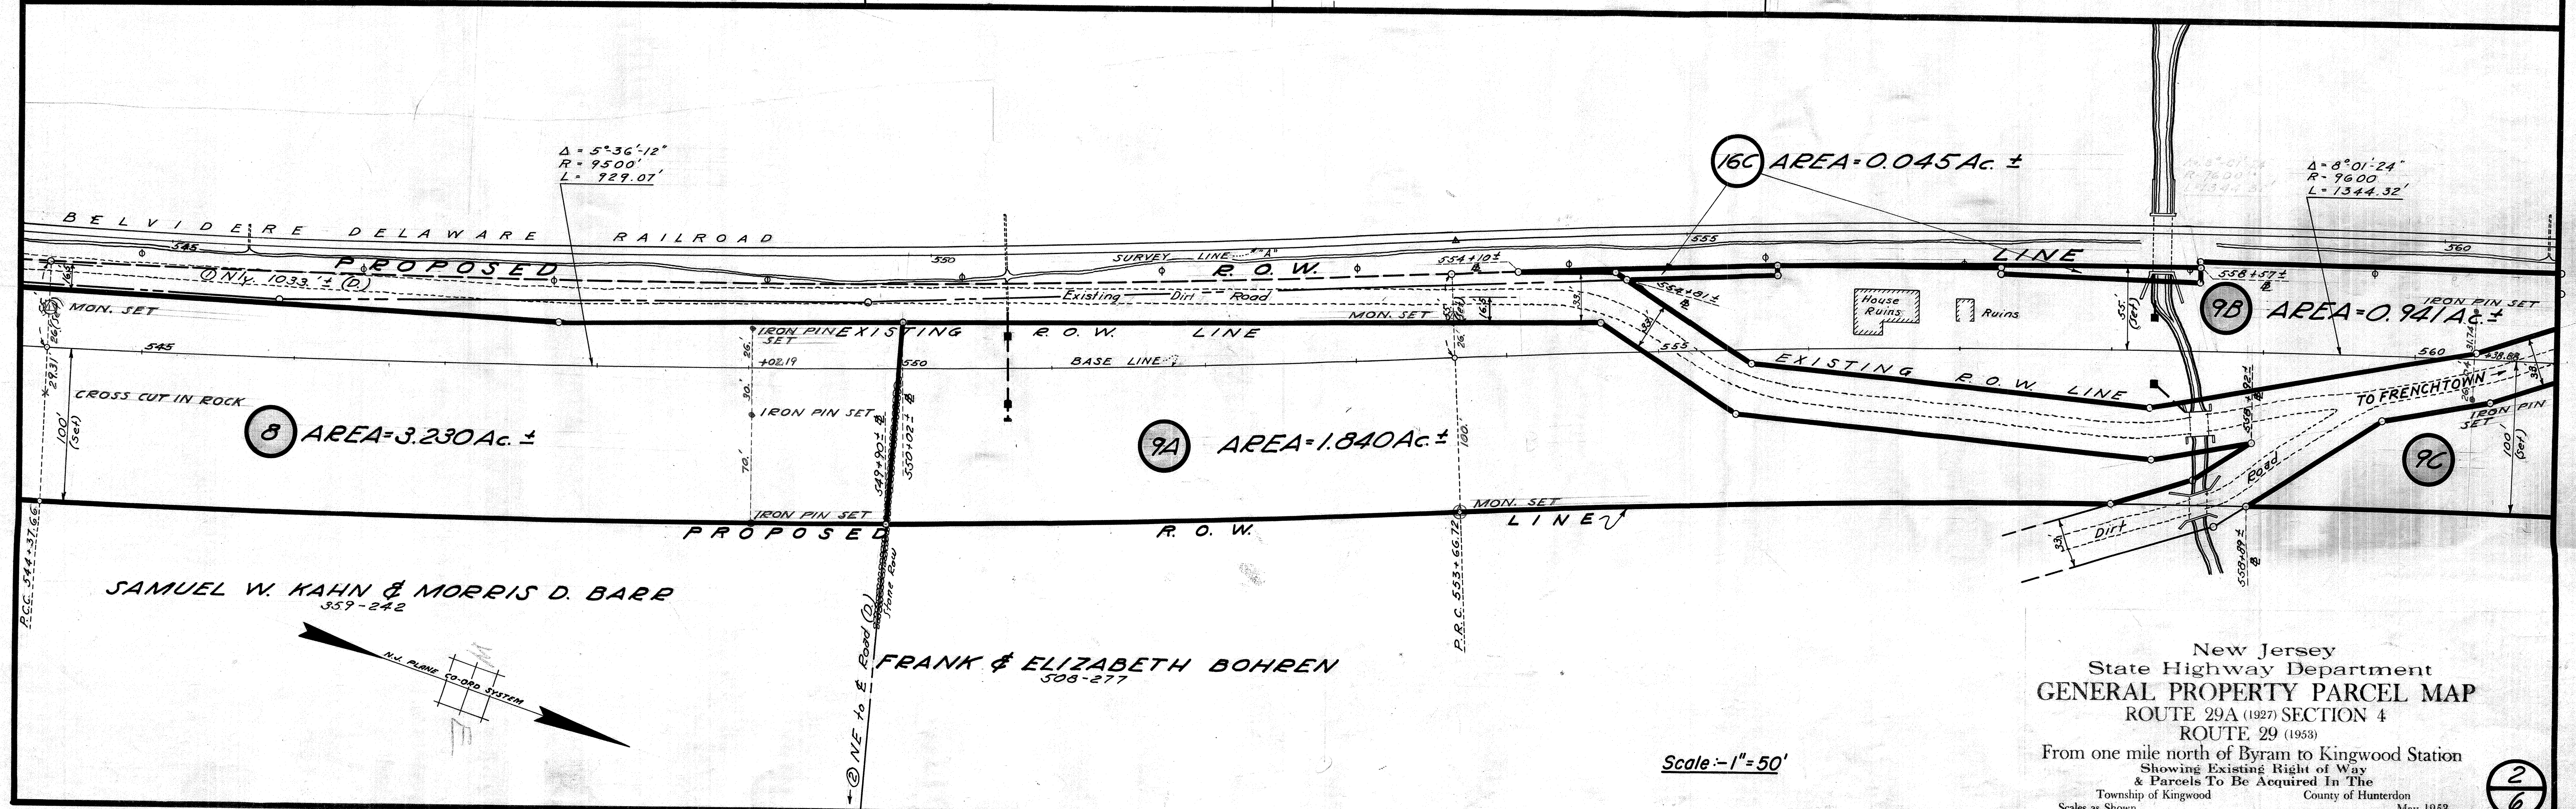



APPENDIX II

Record Plans for Rt. 29

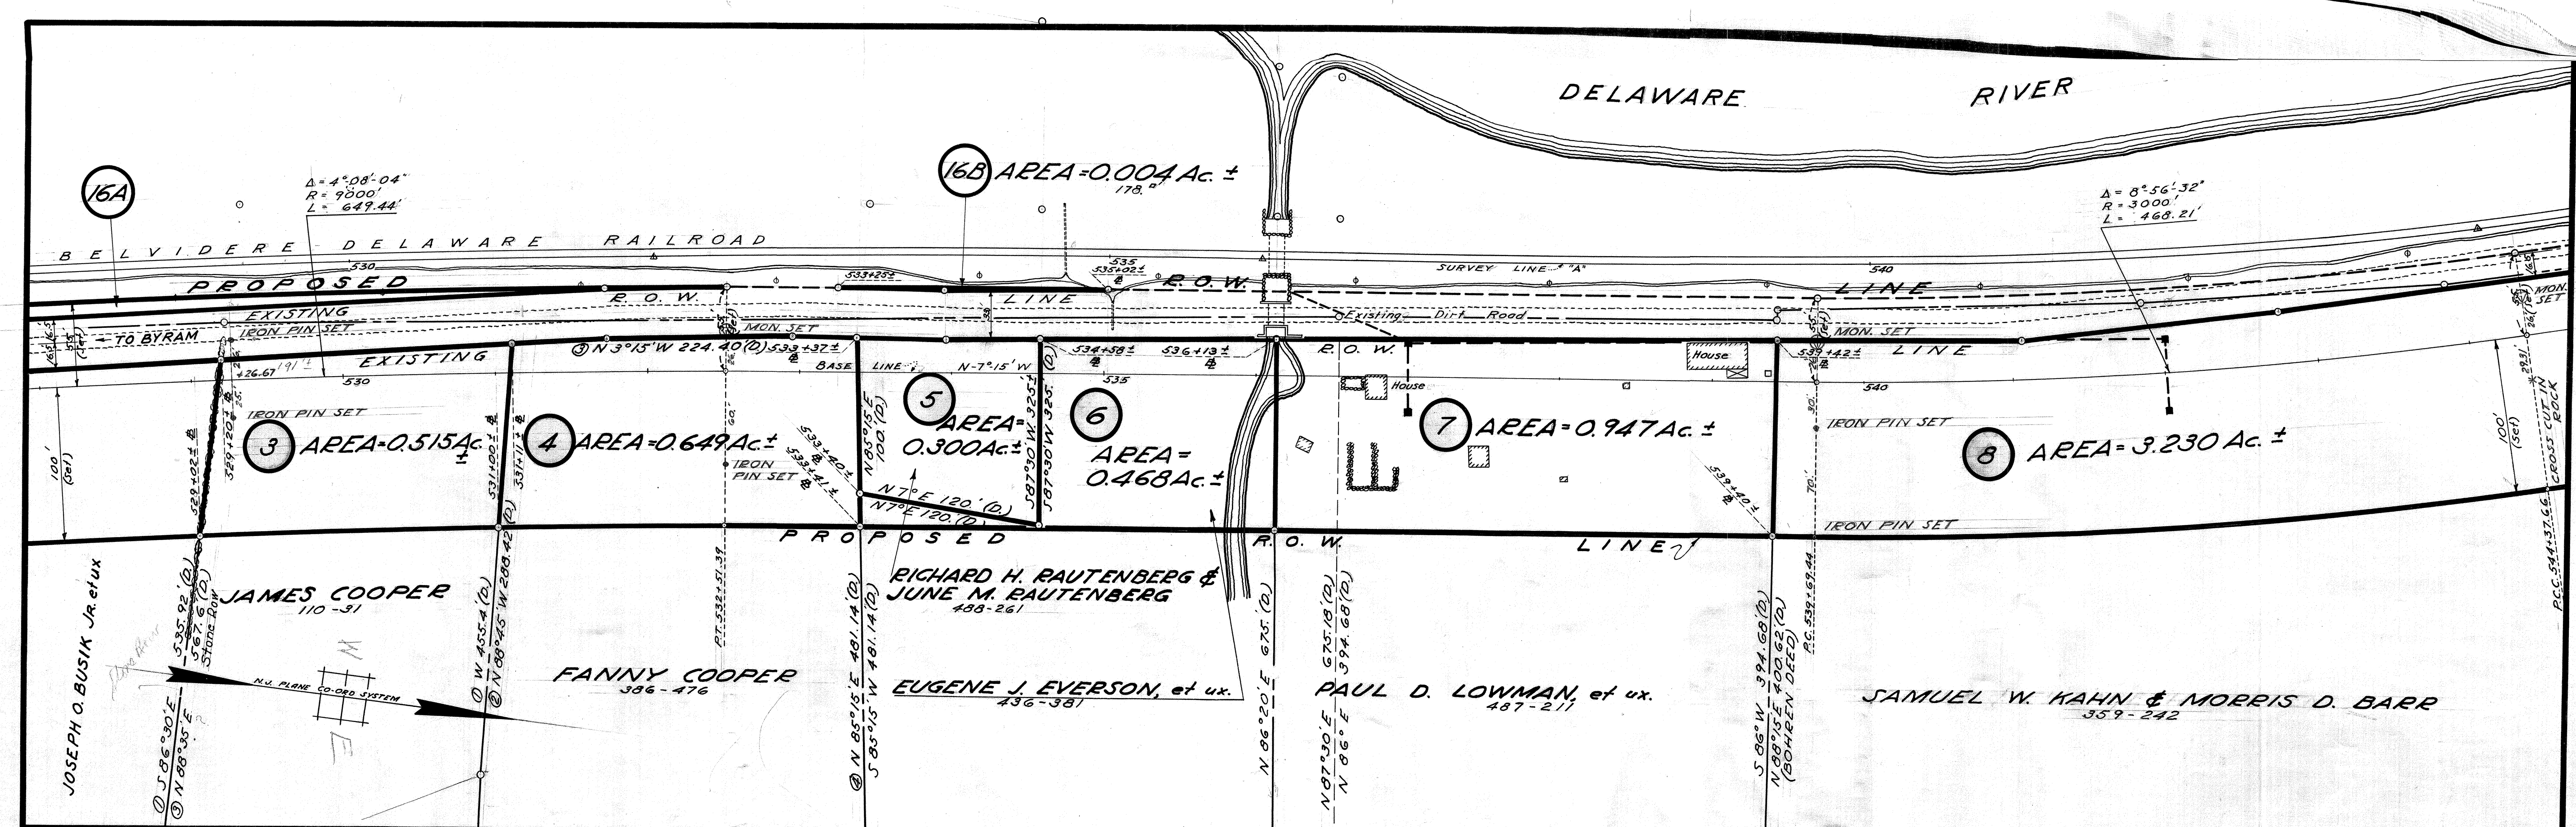

New Jersey
State Highway Department
GENERAL PROPERTY PARCEL MAP
ROUTE 29A (1927) SECTION 4
ROUTE 29 (1953)
From one mile north of Byram to Kingwood Station
Showing Existing Right of Way
& Parcels To Be Acquired In The
Township of Kingwood County of Hunterdon
May 1953


Scale: 1" = 50'

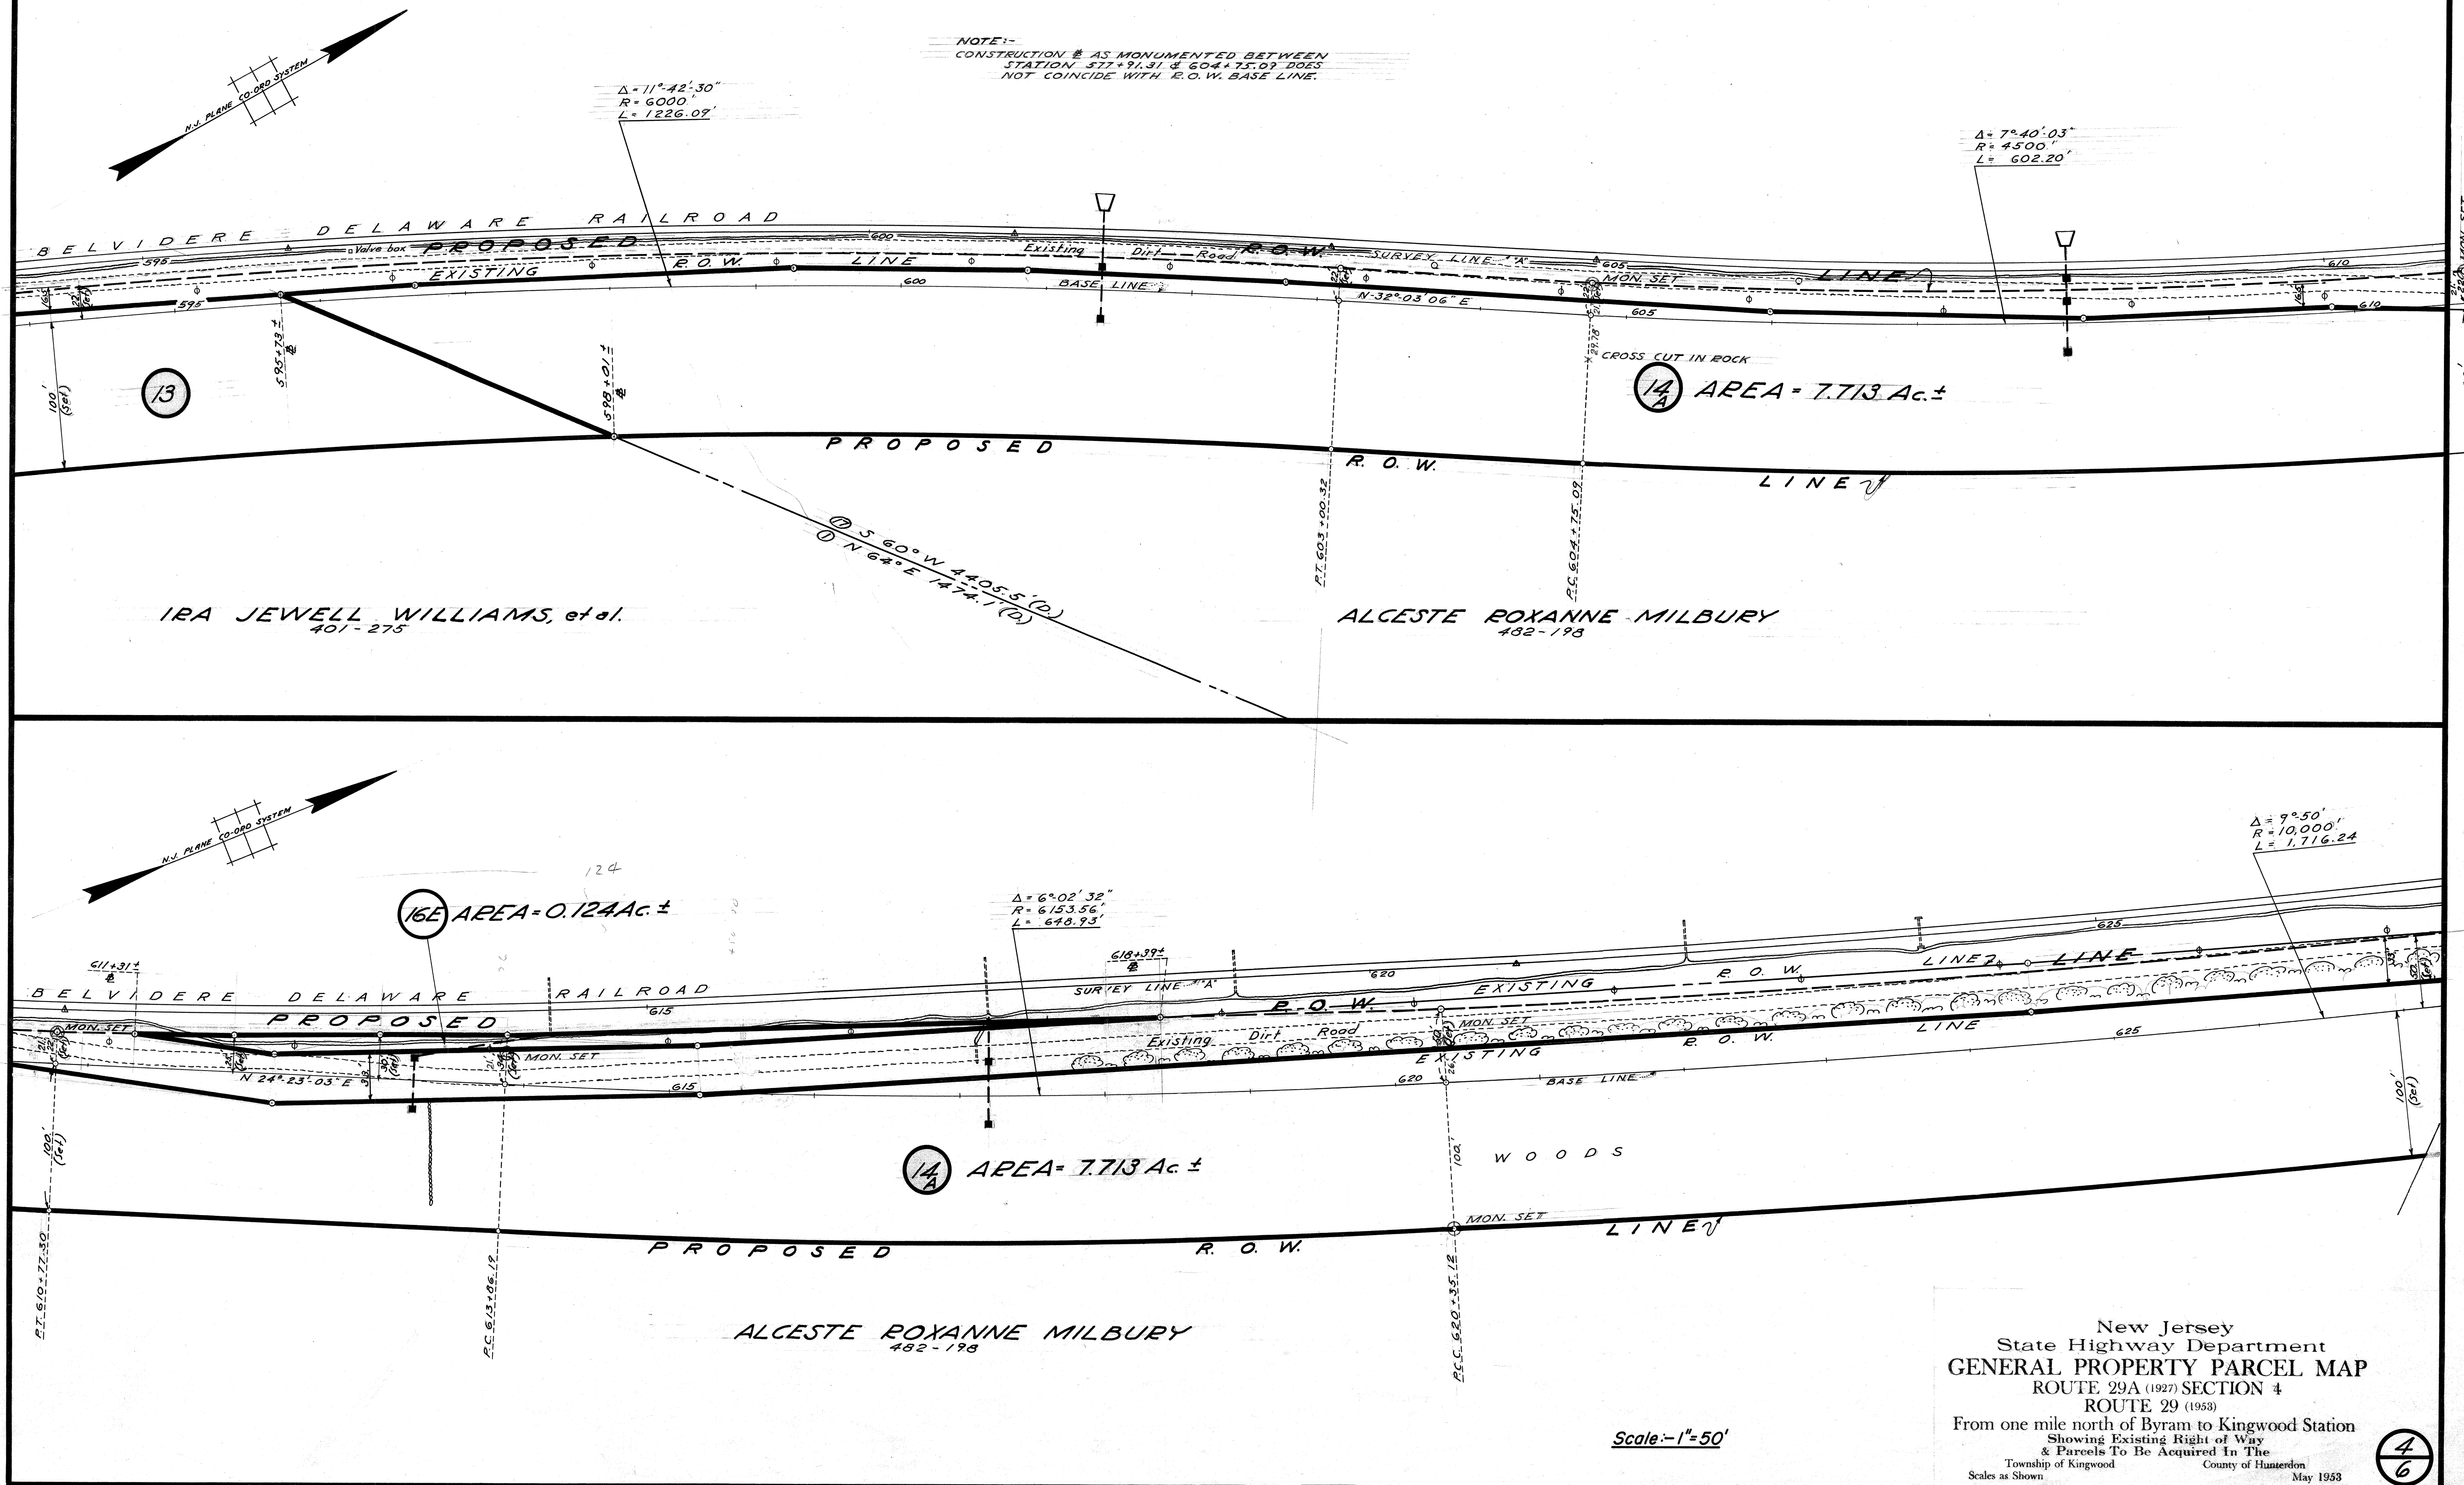

New Jersey
 State Highway Department
GENERAL PROPERTY PARCEL MAP
 ROUTE 29A (1927) SECTION 4
 ROUTE 29 (1953)
 From one mile north of Byram to Kingwood Station
 Showing Existing Right of Way
 & Parcels To Be Acquired In The
 Township of Kingwood County of Hunterdon
 Scales as Shown May 1953

STATE OF NEW JERSEY
HIGHWAY DEPARTMENT
PLANS OF
ROUTE 29A (1927) SECTION 5A
ROUTE 29 (1953)
From Raven Rock to one mile north of Byram
PARTIAL GRADING
Delaware and Kingwood Townships Hunterdon County
Scales as Indicated December 1953

AS-BUILT

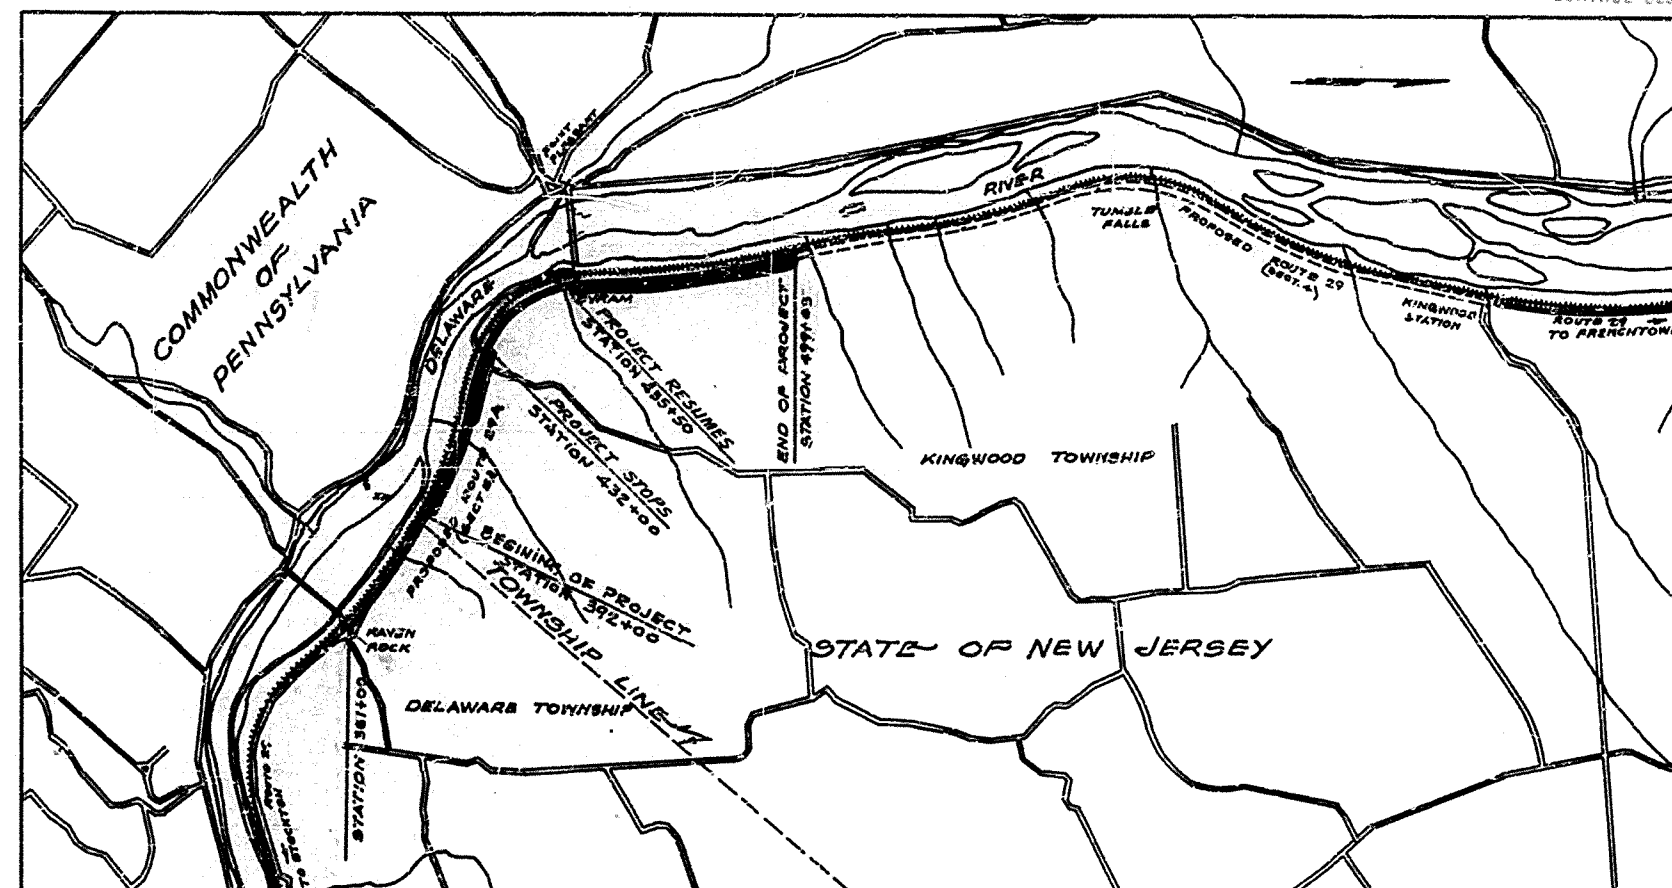

LAYOUT & KEY MAP

SCALE - 1" = $\frac{1}{2}$ MILE



LENGTH OF PROJECT - 8,413 Lin. Ft. - 1.593 Miles

STANDARD HIGHWAY SPECIFICATIONS OF TO GOVERN

INDEX OF SHEETS	
1	KEY SHEET
2	TYPICAL SECTIONS & ESTIMATE OF QUANTITIES SHEET
3	DISTRIBUTION SHEET
4 to 11	PLAN SHEETS
12	TIE SHEET
13 to 33	X-SECTION SHEETS
34	EARTHWORK CHART
35 to 36	PROFILES & X-SECTION OF CULVERTS
37 to 40	CONSTRUCTION DETAILS

UTILITIES	
PENNSYLVANIA RAILROAD CO.	
NEW YORK CITY, N.Y.	
N.J. BELL TELEPHONE CO.	
TRENTON, N.J.	
N.J. POWER & LIGHT CO.	
PHILLIPSBURG, N.J.	

Submitted by Fred L. Gerard 12-29-53
Ass't. Director and Chief Road Engineer Date
Approved by G. Herbert Butts 12-29-53
Ass't. State Highway Engineer Date
Approved by W. C. C. C. 12-29-53
State Highway Commissioner Date

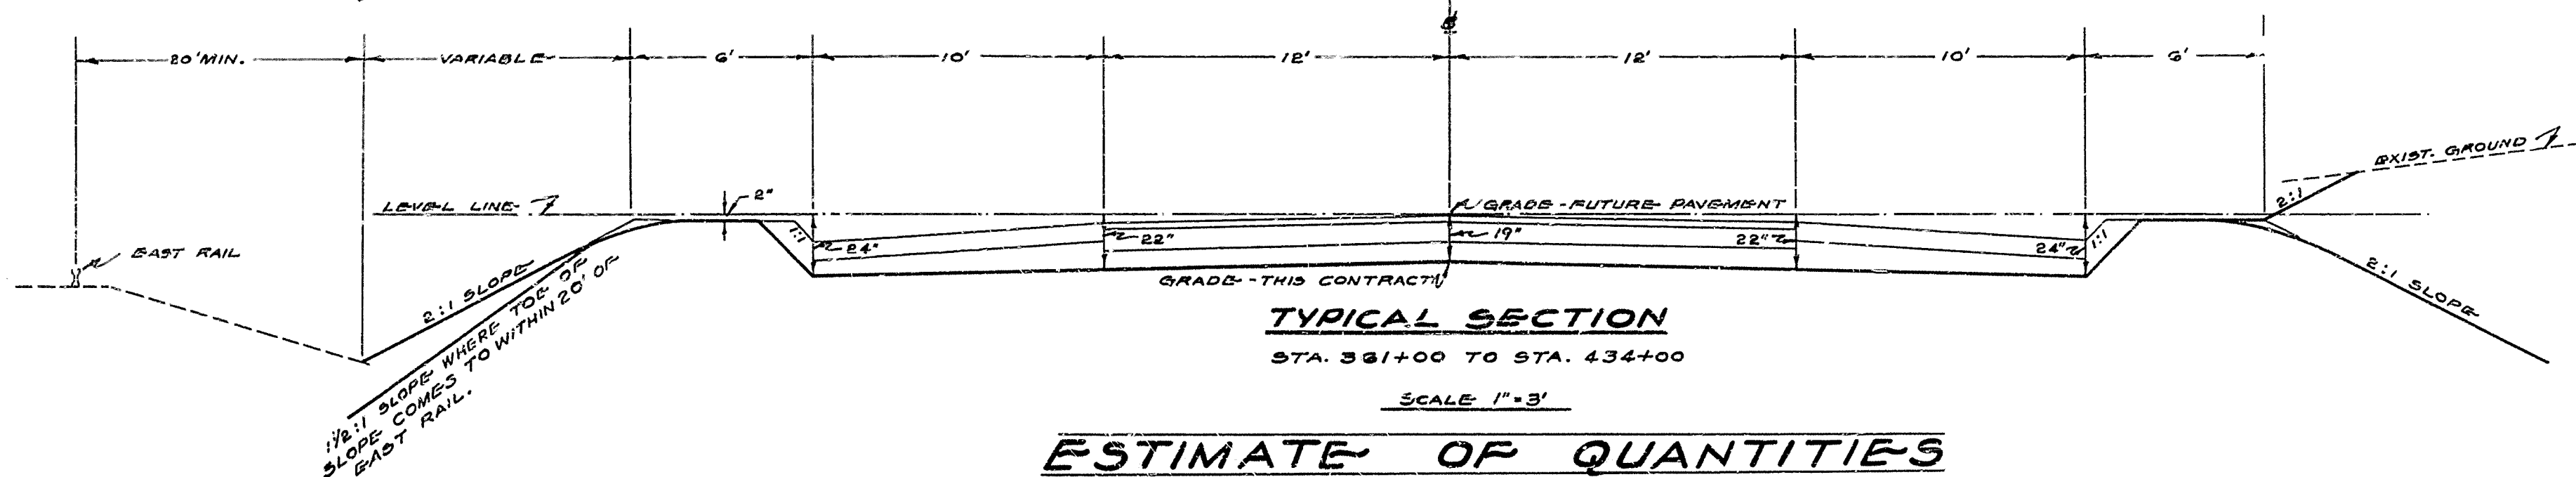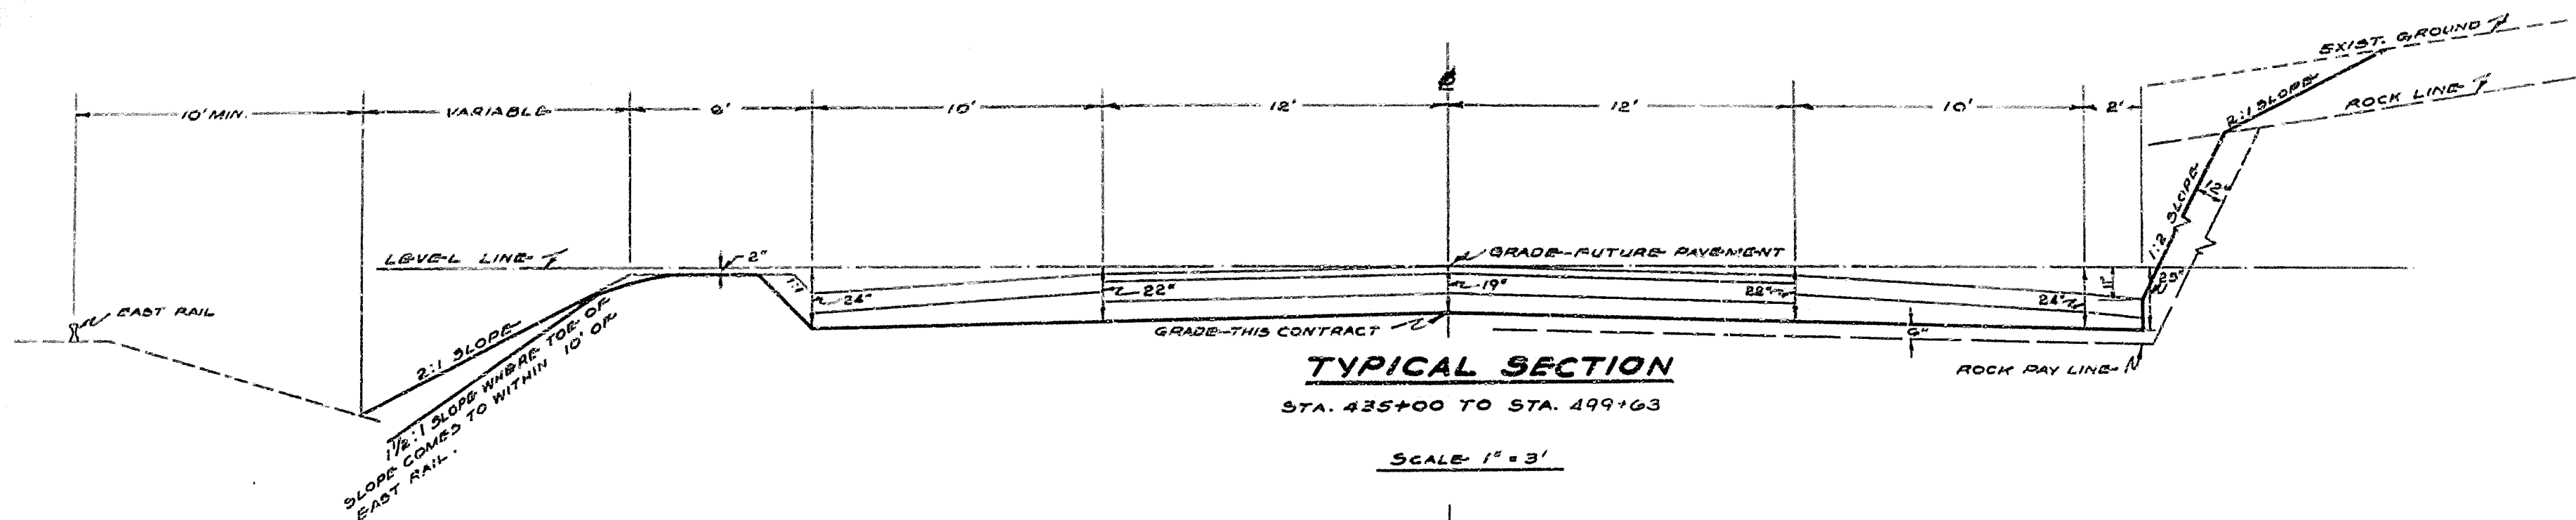


ESTIMATE OF QUANTITIES

ITEM	DESCRIPTION	UNIT	QUANTITY	AS BUILT	ITEM	DESCRIPTION	UNIT	QUANTITY	AS BUILT	ITEM	DESCRIPTION	UNIT	QUANTITY	AS BUILT
1	FIELD OFFICE	L.S.	LUMP SUM	LUMP SUM	27	GROUTED RUBBLE STONE CUTTER	S.Y.	80	54					
2	CLEARING SITE	L.S.	LUMP SUM	LUMP SUM	28	HEADWALLS	C.Y.	150	180					
3	STRIPPING, 8" DEPTH	ACRE	10	10	29	WOOD BARRICADE	L.F.	200	179					
4	ROADWAY EXCAVATION, EARTH	C.Y.	15,168	0	30	DEMOLITION OF 2 STORY FRAME DWELLING, AT STATION 457+15	L.S.	LUMP SUM	LUMP SUM					
5	ROADWAY EXCAVATION, ROCK	C.Y.	114,012	0	SA-1	ROADWAY EXCAVATION UNCLASSIFIED	C.Y.		198,138					
6	BORROW EXCAVATION	C.Y.	15000	ACRE	SA-4	CLEARING SITE	ACRES		5					
7	CHANNEL EXCAVATION	C.Y.	500	212	SA-4	CALCIUM CHLORIDE	TONS		2					
8	DITCH EXCAVATION, EARTH	C.Y.	400	323										
9	DITCH EXCAVATION, ROCK	C.Y.	200	73										
10	ROCK EXCAVATION, SUBSURFACE STRUCTURES	C.Y.	1000	434										
11	EARTH EXCAVATION, SUBSURFACE STRUCTURES, ADDITIONAL DEPTH	C.Y.	100	NONE										
12	4" TOP SOILING	S.Y.	25000	27,090										
13	MULCHING (HAY)	S.Y.	20000	27,090										
14	BROKEN STONE OR WASHED GRAVEL	TONS	260	60										
15	UNDERDRAIN, TYPE F	L.F.	2,000	165										
16	18" REINFORCED CONCRETE CULVERT PIPE	L.F.	646	724										
17	24" REINFORCED CONCRETE CULVERT PIPE	L.F.	66	89										
18	30" REINFORCED CONCRETE CULVERT PIPE	L.F.	90	90										
19	18" CAST IRON CULVERT PIPE, EXTRA HEAVY	L.F.	200	205										
20	18" CORRUGATED METAL CULVERT PIPE BITUMINOUS COATED PAVED INVERT	L.F.	178	178										
21	6'-5" x 4'-10" CORRUGATED METAL PLATE PIPE ARCH	L.F.	74	74										
22	11'-10" x 7'-7" CORRUGATED METAL PLATE PIPE ARCH	L.F.	100	101										
23	INLETS, TYPE B	UNIT	15	15										
24	INLETS, TYPE E	UNIT	5	3										
25	INLET BOXES	UNIT	2	2										
26	EXTRA DEPTH OF INLETS, BELOW 8 FEET	L.F.	20	15										

New Jersey
State Highway Department
ESTIMATE OF QUANTITIES
TYPICAL SECTIONS
ROUTE 29A (1927) SECTION 5A
ROUTE 29 (1958)
From Raven Rock to one mile north of Byram
PARTIAL GRADING
Scale as Indicated


1008 002 | 040

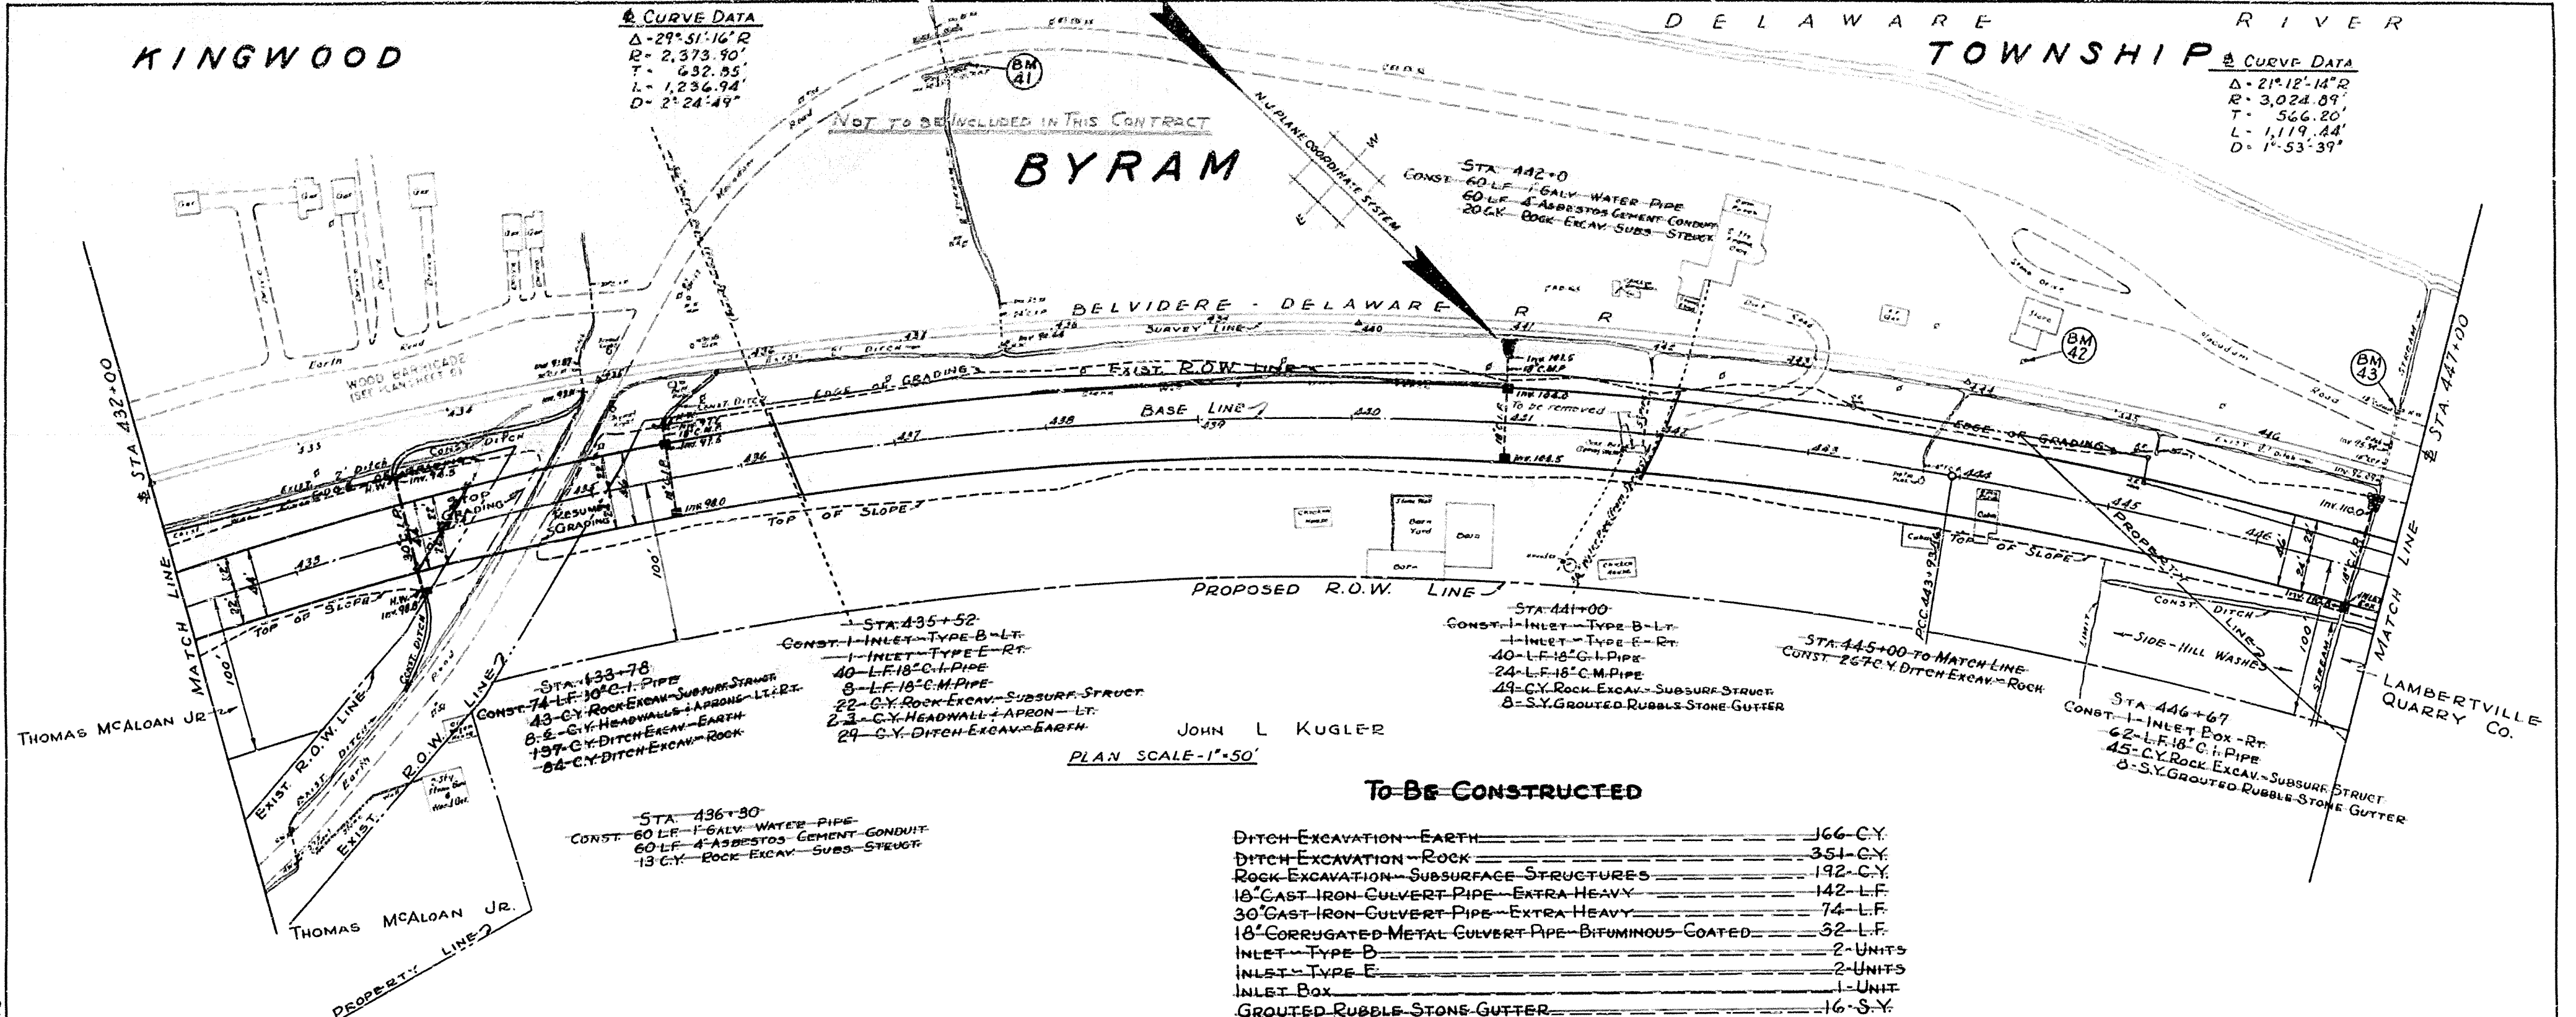

TO BE CONSTRUCTED

DITCH EXCAVATION - EARTH	166 C.Y.
DITCH EXCAVATION - ROCK	351 C.Y.
ROCK EXCAVATION - SUBSURFACE STRUCTURES	192 C.Y.
18" CAST IRON CULVERT PIPE - EXTRA HEAVY	142 L.F.
30" CAST IRON CULVERT PIPE - EXTRA HEAVY	74 L.F.
18" CORRUGATED METAL CULVERT PIPE - BITUMINOUS COATED	32 L.F.
INLET - TYPE B	2 UNITS
INLET - TYPE E	2 UNITS
INLET BOX	1 UNIT
GROUTED RUBBLE STONE GUTTER	16 S.Y.
HEADWALLS	10.3 C.Y.
1" GALVANIZED WATER PIPE	120 L.F.
4 ASBESTOS CEMENT CONDUIT	120 L.F.

B.M. #41 - EL. 93.53 (U.S.C. & G. BENCH)
 U.S.C. & G. MARKER IN NW COR. OF N.H.W.
 OF BRIDGE - STA. 437+57 - 170' LT.
 OF SURVEY LINE.
 B.M. #42 - EL. 100.67
 SPIKE IN POLE - STA. 444+35 - 15'
 LT. OF SURVEY LINE.
 B.M. #43 - EL. 97.32
 CROSS CUT IN S. END OF CONC. H.W.
 * K-11 - STA. 446+80 - 40' LT. OF
 SURVEY LINE.


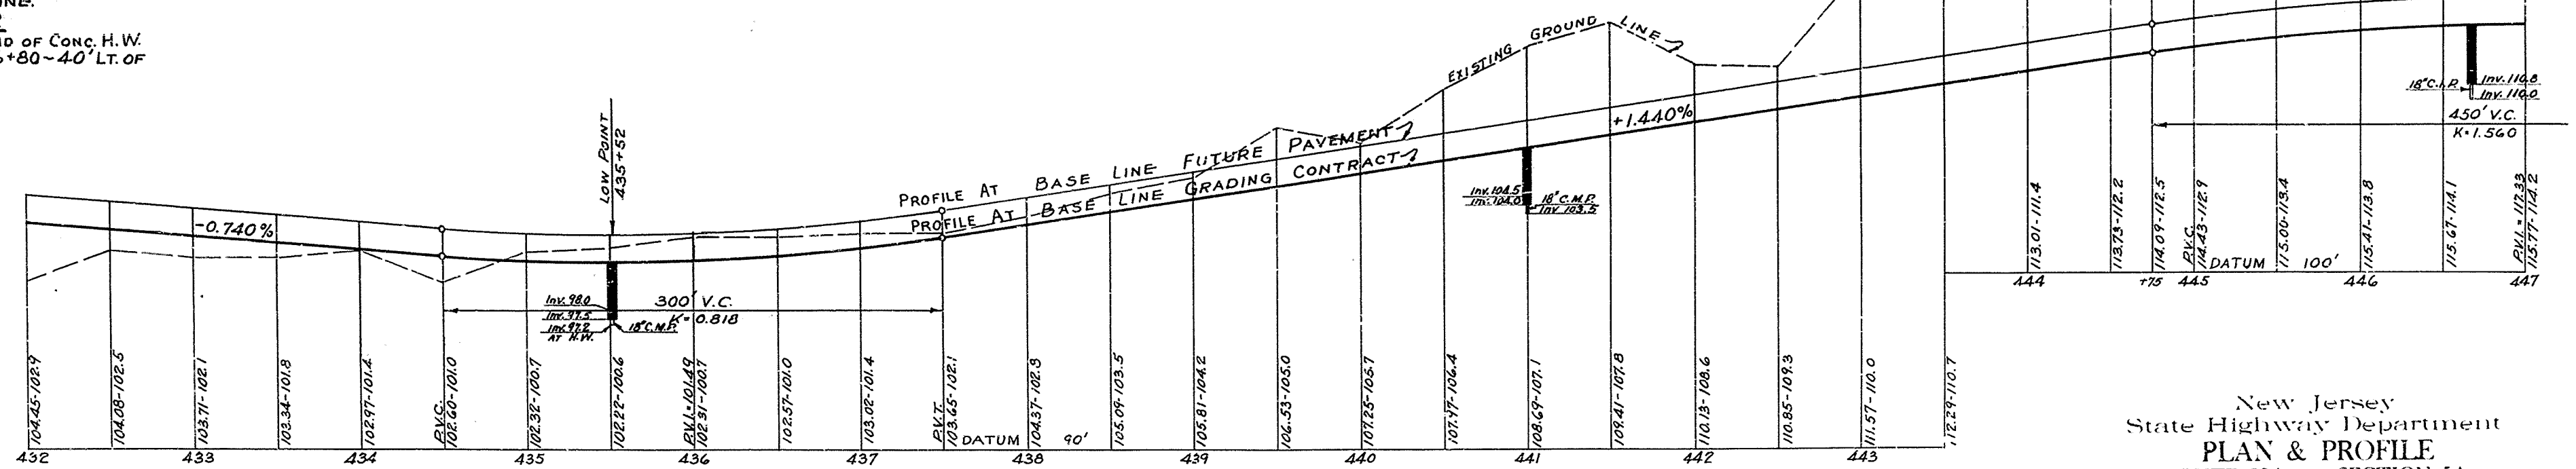


DELAWARE
KINGWOOD

CURVE DATA
 $\Delta = 10^\circ 58' 19''$
 $R = 4,000.00'$
 $T = 364.17'$
 $L = 765.99'$
 $D = 1^\circ 25' 57''$

RIVER
TOWNSHIP

CURVE DATA
 $\Delta = 9^\circ 48' 53''$
 $R = 6,000.00'$
 $T = 515.16'$
 $L = 1,027.80'$
 $D = 0^\circ 57' 18''$

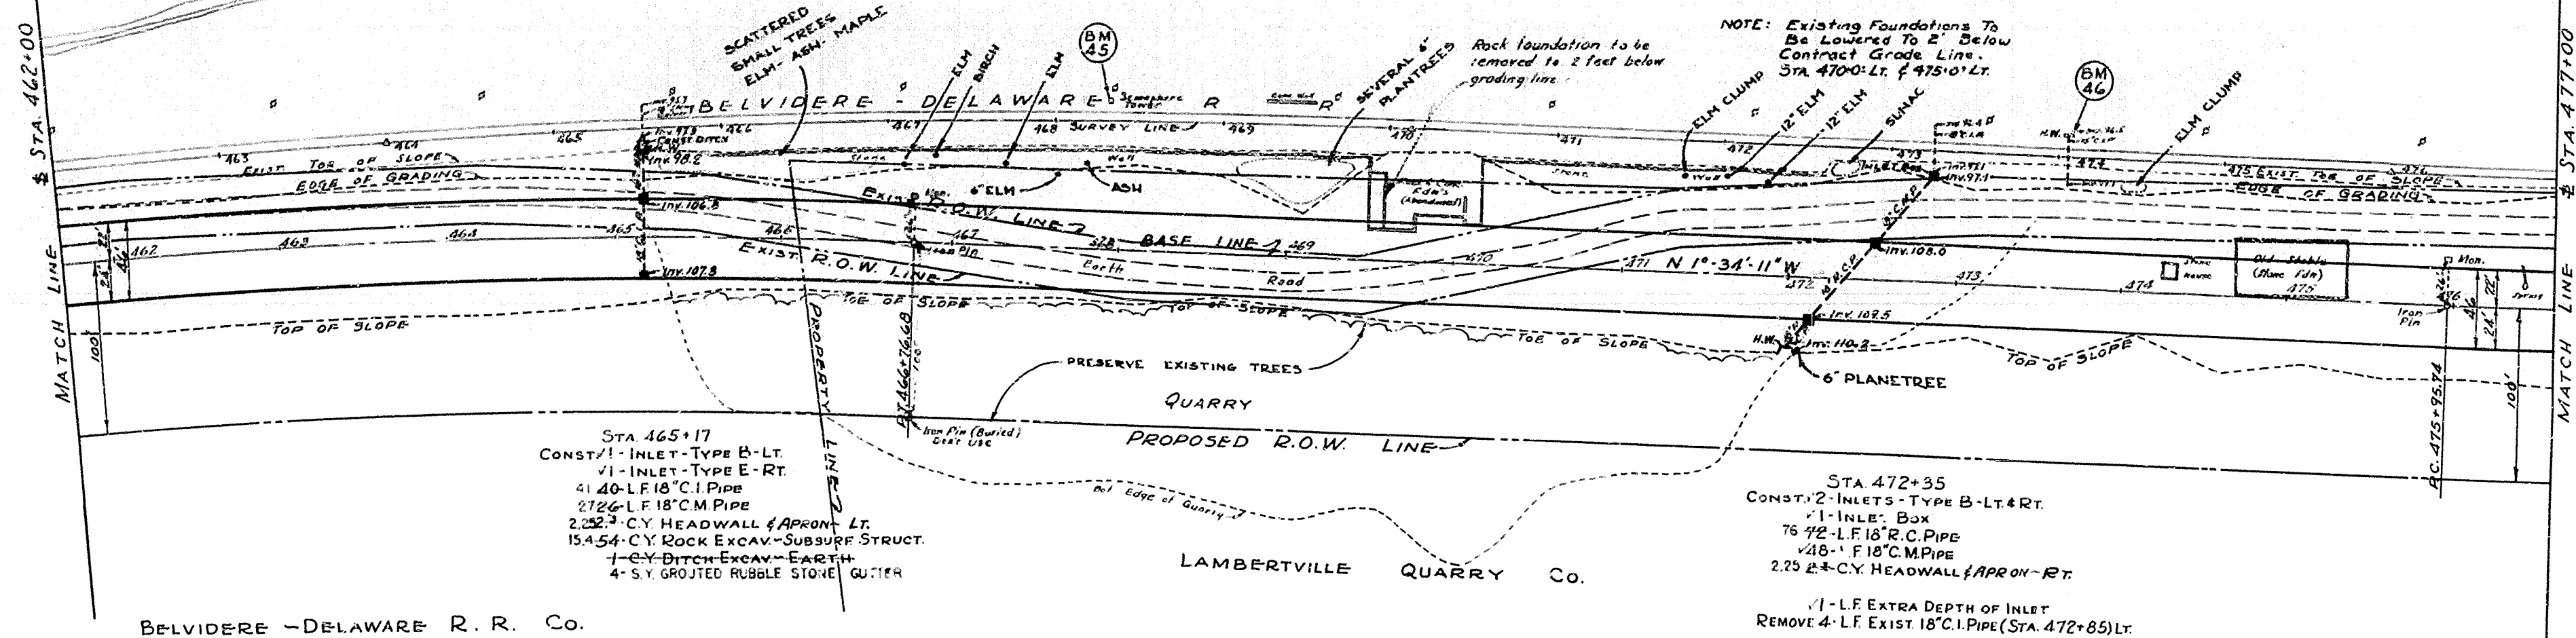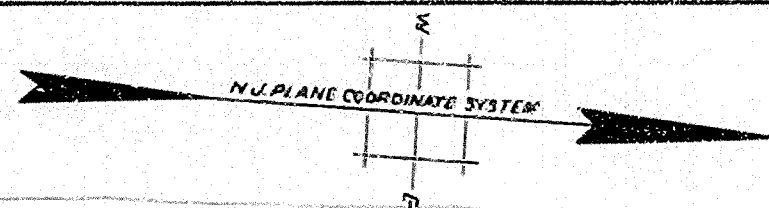


PLAN SCALE - 1" = 50'

TO BE CONSTRUCTED

DITCH EXCAVATION - EARTH	1 C.Y.
ROCK EXCAVATION - SUBSURFACE STRUCTURES	54 C.Y. 15.4
18" REINFORCED CONCRETE CULVERT PIPE	72 L.F. 7.0
18" CAST IRON CULVERT PIPE - EXTRA HEAVY	40 L.F. 4.1
18" CORRUGATED METAL CULVERT PIPE - BITUMINOUS COATED	74 L.F. 7.5
INLET TYPE B	3 UNITS
INLET TYPE E	1 UNIT
INLET BOX	1 UNIT
EXTRA DEPTH OF INLET	1 L.F.
HEADWALLS	4.5 C.Y. 4.5
GROUTED RUBBLE STONE CUTTER	4 S.Y.

FOR CROSS-SECTIONS
SEE SHEETS 23, 24, 25 & 26

B.M. #45 - E.L. 99.87
S.E. COR. OF CONC. BASE OF SEMAPHORE STA.
468+33.12' LT. OF SURVEY LINE.
B.M. #46 - E.L. 98.34
N.W. COR. OF HEADWALL - STA. 474+08.9' LT.
OF SURVEY LINE.

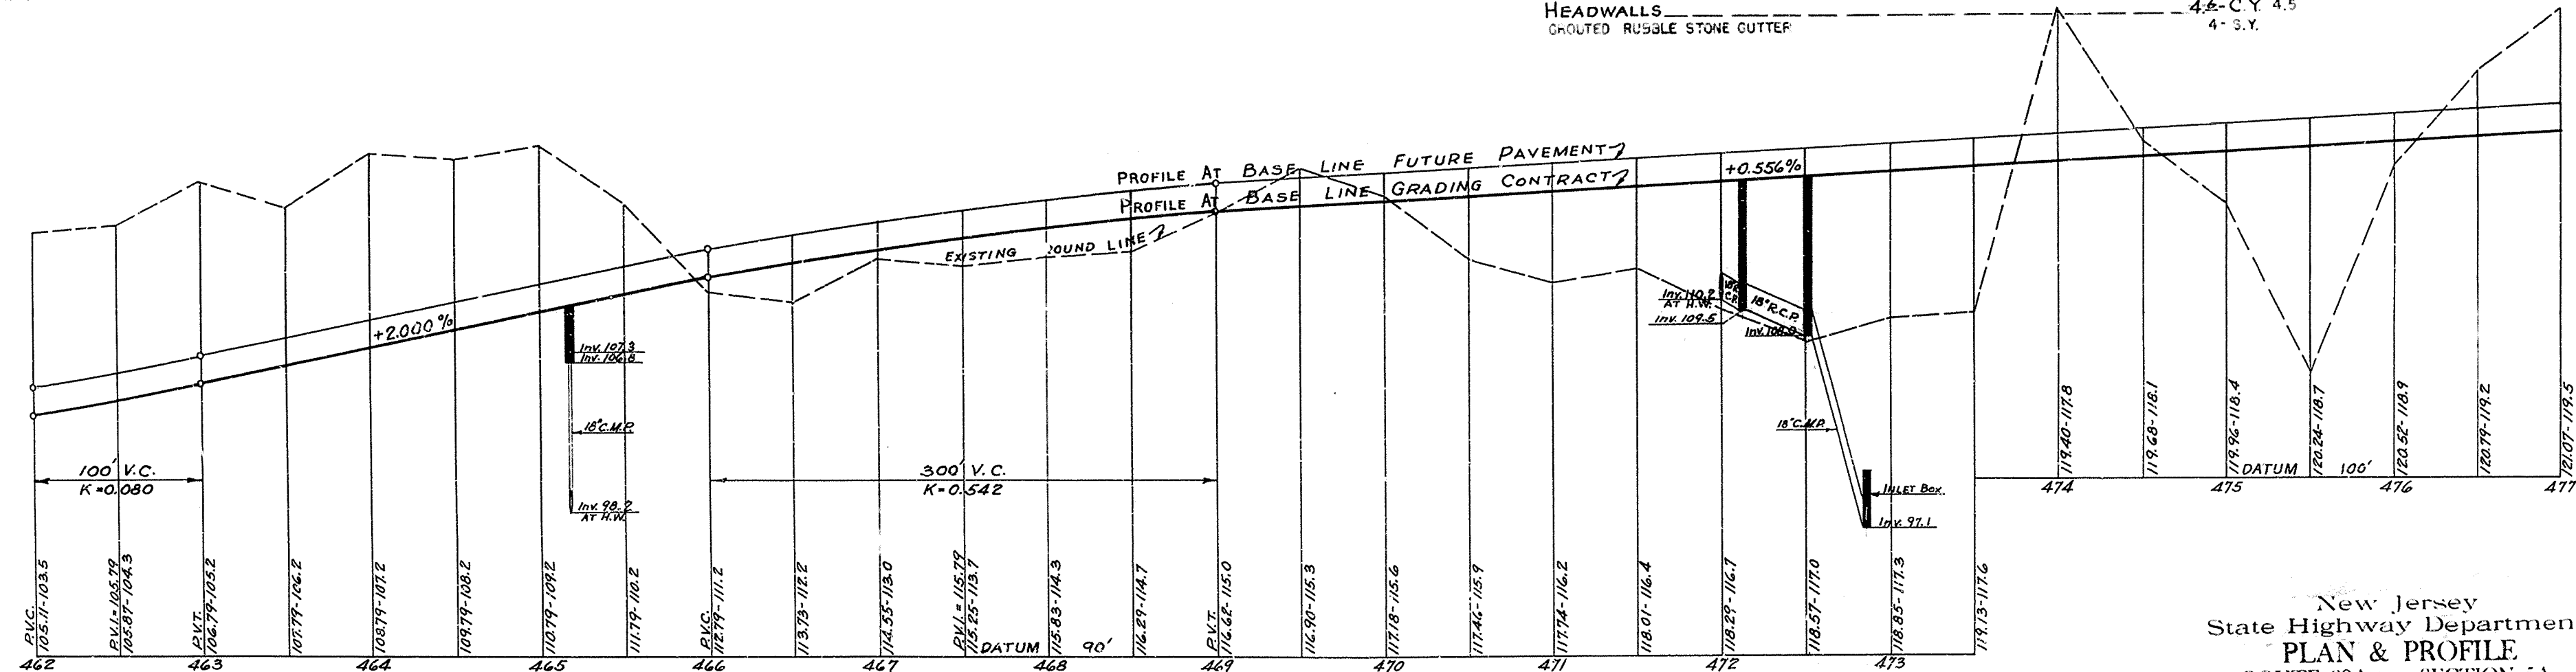

PROFILE SCALE: HOR. 1" = 50'
VERT. 1" = 5'


New Jersey
State Highway Department
PLAN & PROFILE
ROUTE 29A (1927) SECTION 5A
ROUTE 29 (1953)
From Raven Rock to one mile north of Byram
PARTIAL GRADING
Scales as Indicated

Books 1 to 10 - SHERMAN, TAYLOR & SLEEPER, MERCANTVILLE, N.J.

1008 009 040

DELAWARE KINGWOOD TOWNSHIP RIVER

CURVE DATA
 $\Delta = 9^\circ 48' 53''$
 $R = 6,000.00'$
 $T = 515.16'$
 $L = 1027.80'$
 $D = 0^\circ 37' 18''$

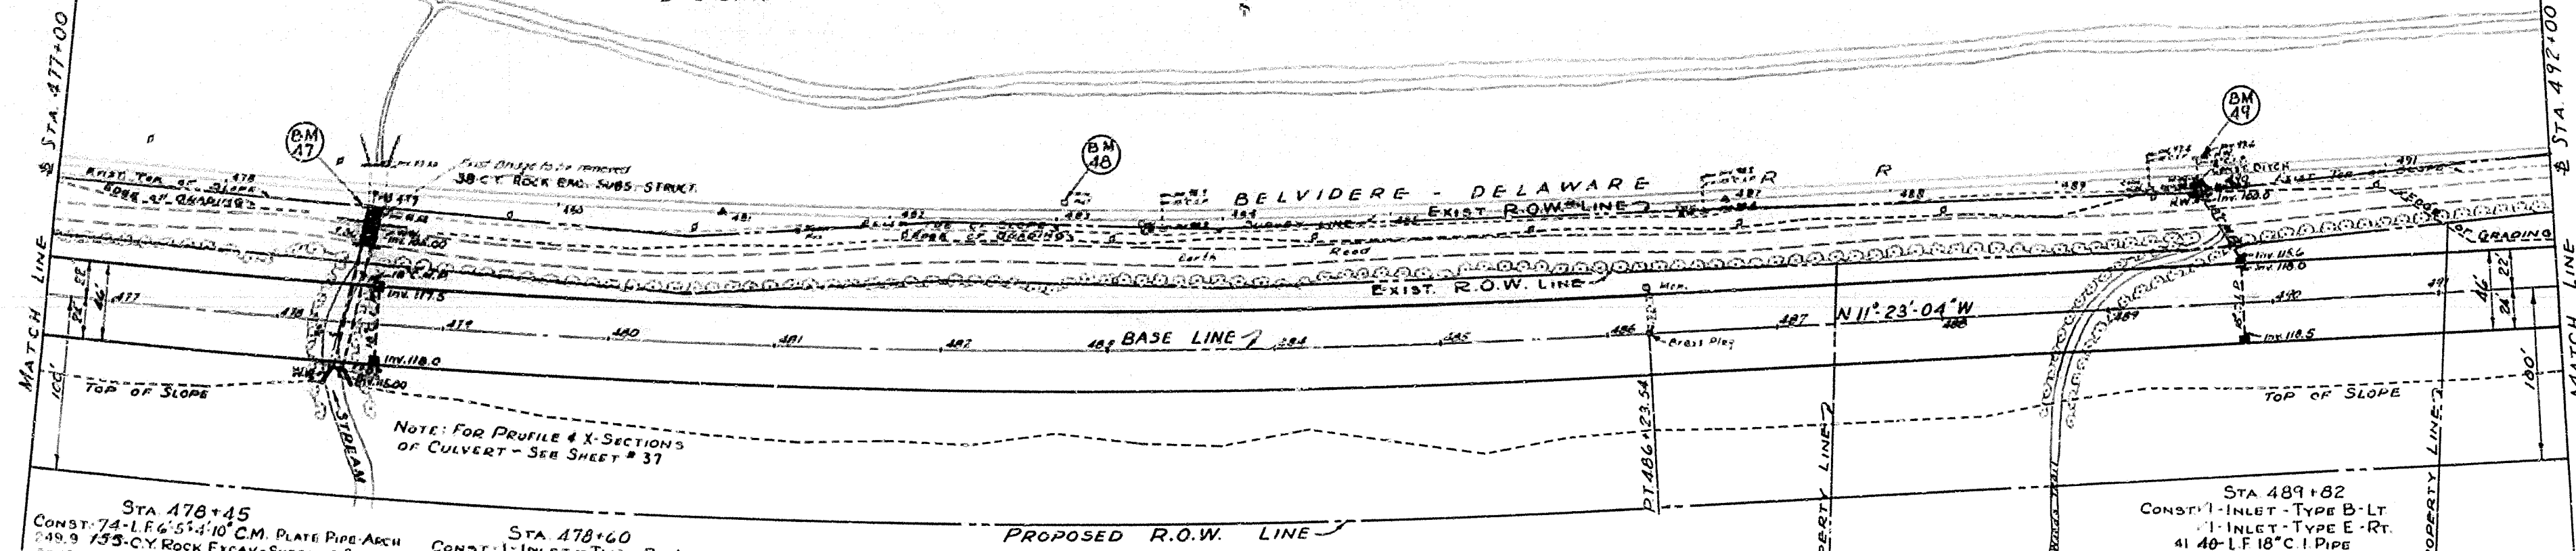

STA 478+45
 CONST. 74'-L.F. 5'-10" C.M. PLATE PIPE-ARCH
 249.9 C.Y. ROCK EXCAV. - SUBSURF. STRUCT.
 59.12 47'-25" C.Y. HEADWALL - LT. & RT.
 105 C.Y. CHANNEL EXCAV.
 242 47'-5" GROUTED RUBBLE STONE GUTTER
 73 C.Y. DITCH EXCAVATION - ROCK

STA 478+60
 CONST. 1'-INLET - TYPE B - LT.
 1'-INLET - TYPE E - RT.
 41 40'-L.F. 18" C.I. PIPE
 15 18'-L.F. 18" C.M. PIPE (INCL. 1-90° ELBOW)
 156 22 C.Y. ROCK EXCAV. - SUBSURF. STRUCT.

LAMBERTVILLE QUARRY CO.
 PLAN SCALE - 1"=50'


TO BE CONSTRUCTED

CHANNEL EXCAVATION -	105 C.Y.
DITCH EXCAVATION - EARTH	4 C.Y.
ROCK EXCAVATION - SUBSURFACE STRUCTURES	237 C.Y. 201.8
18" CAST IRON CULVERT PIPE - EXTRA HEAVY	80 L.F. 82
18" CORRUGATED METAL CULVERT PIPE - BITUMINOUS COATED	62 L.F. 50
6'-5" x 4'-10" C.M. PLATE PIPE-ARCH CULVERT	74 L.F.
INLET - TYPE B	2 UNITS
INLET - TYPE E	2 UNITS
HEADWALLS	50.25 C.Y. 61.37
GROUTED RUBBLE STONE GUTTER	17 S.Y. 27
DITCH EXCAVATION - ROCK	73 C.Y.

NOTE: DEEDS OVERLAP 2.5' GROUTED RUBBLE STONE GUTTER
 SOLOMON BERKOWITZ

FOR CROSS-SECTIONS
 SEE SHEETS # 26, 27, 28, 29 & 30


B.M. #47 - EL. 98.78
 CROSS CUT IN S. END OF E. HEADWALL
 STA. 478+83 - 8' RT. OF SURVEY LINE.
 B.M. #48 - EL. 103.97
 TOP OF MILE POST #43-25 - STA. 483+05
 10' LT. OF SURVEY LINE.
 B.M. #49 - EL. 99.72
 N.W. COR. OF W. END OF CONC. WALL - STA.
 489+85 - 10' LT. OF SURVEY LINE.

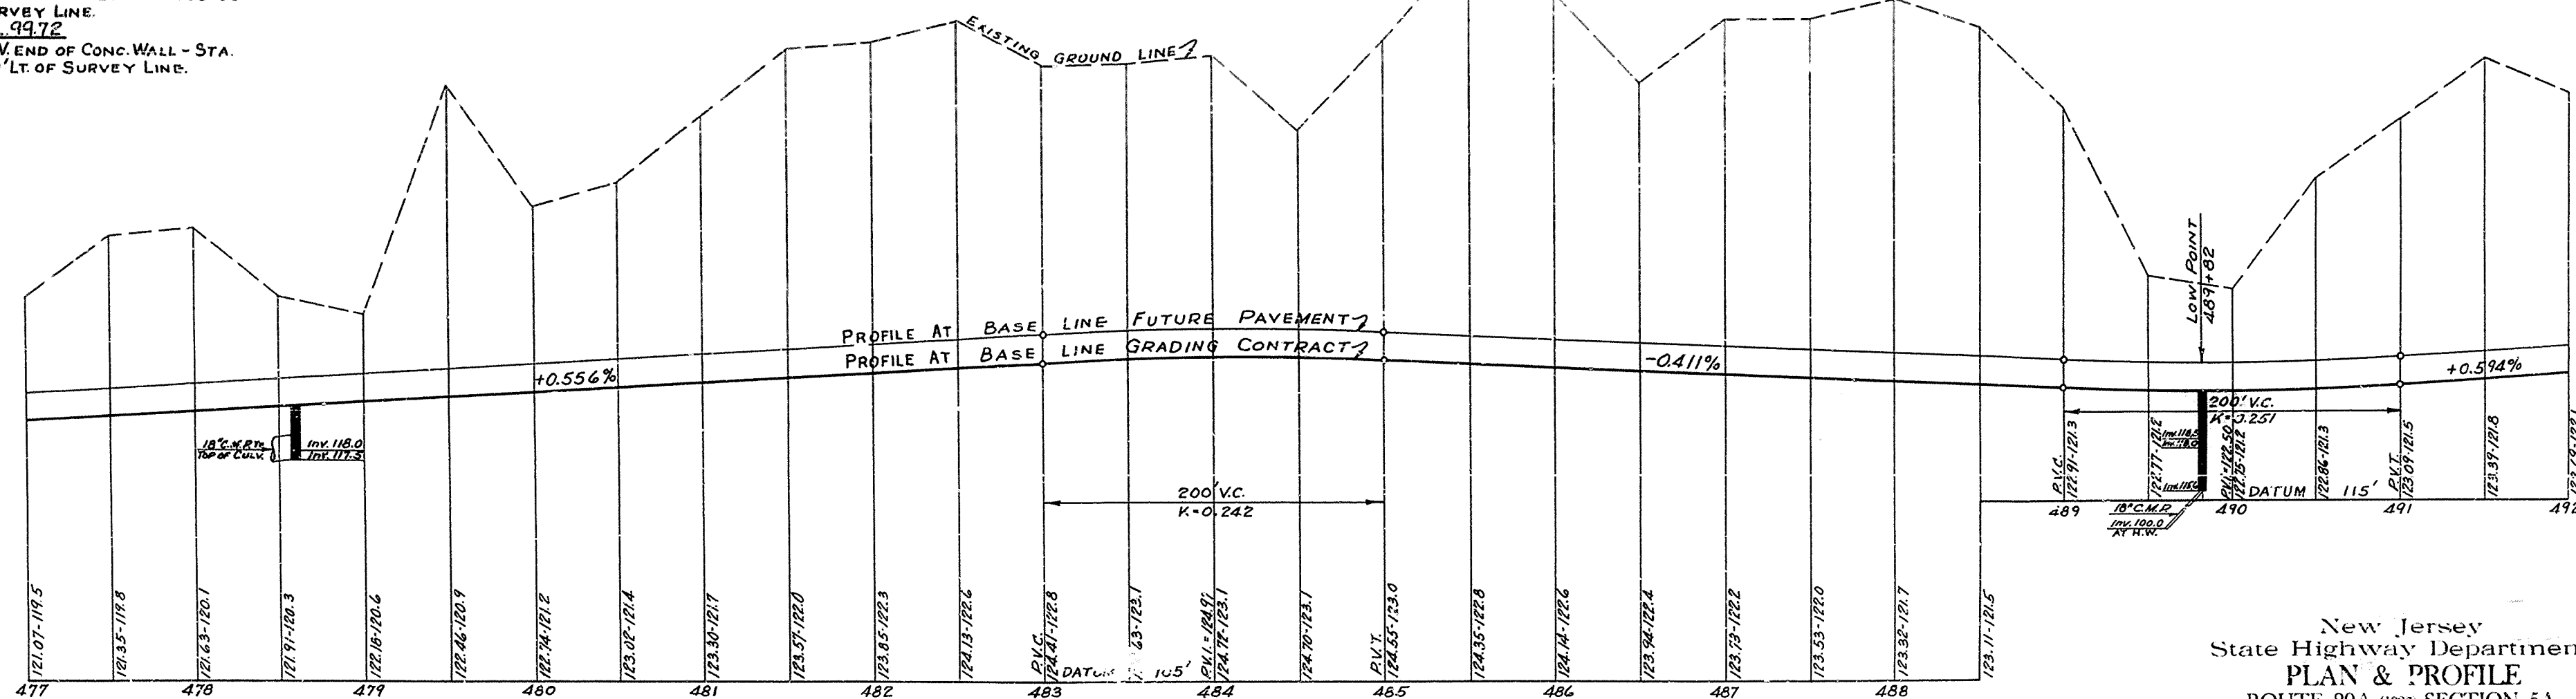


PROFILE SCALE: HOR. 1"=50'
 VERT. 1"=5'

New Jersey
 State Highway Department
PLAN & PROFILE
 ROUTE 29A (1927) SECTION 5A
 ROUTE 29 (1953)
 From Raven Rock to one mile north of Byram
 PARTIAL GRADING
 Scales as Indicated

10
 40

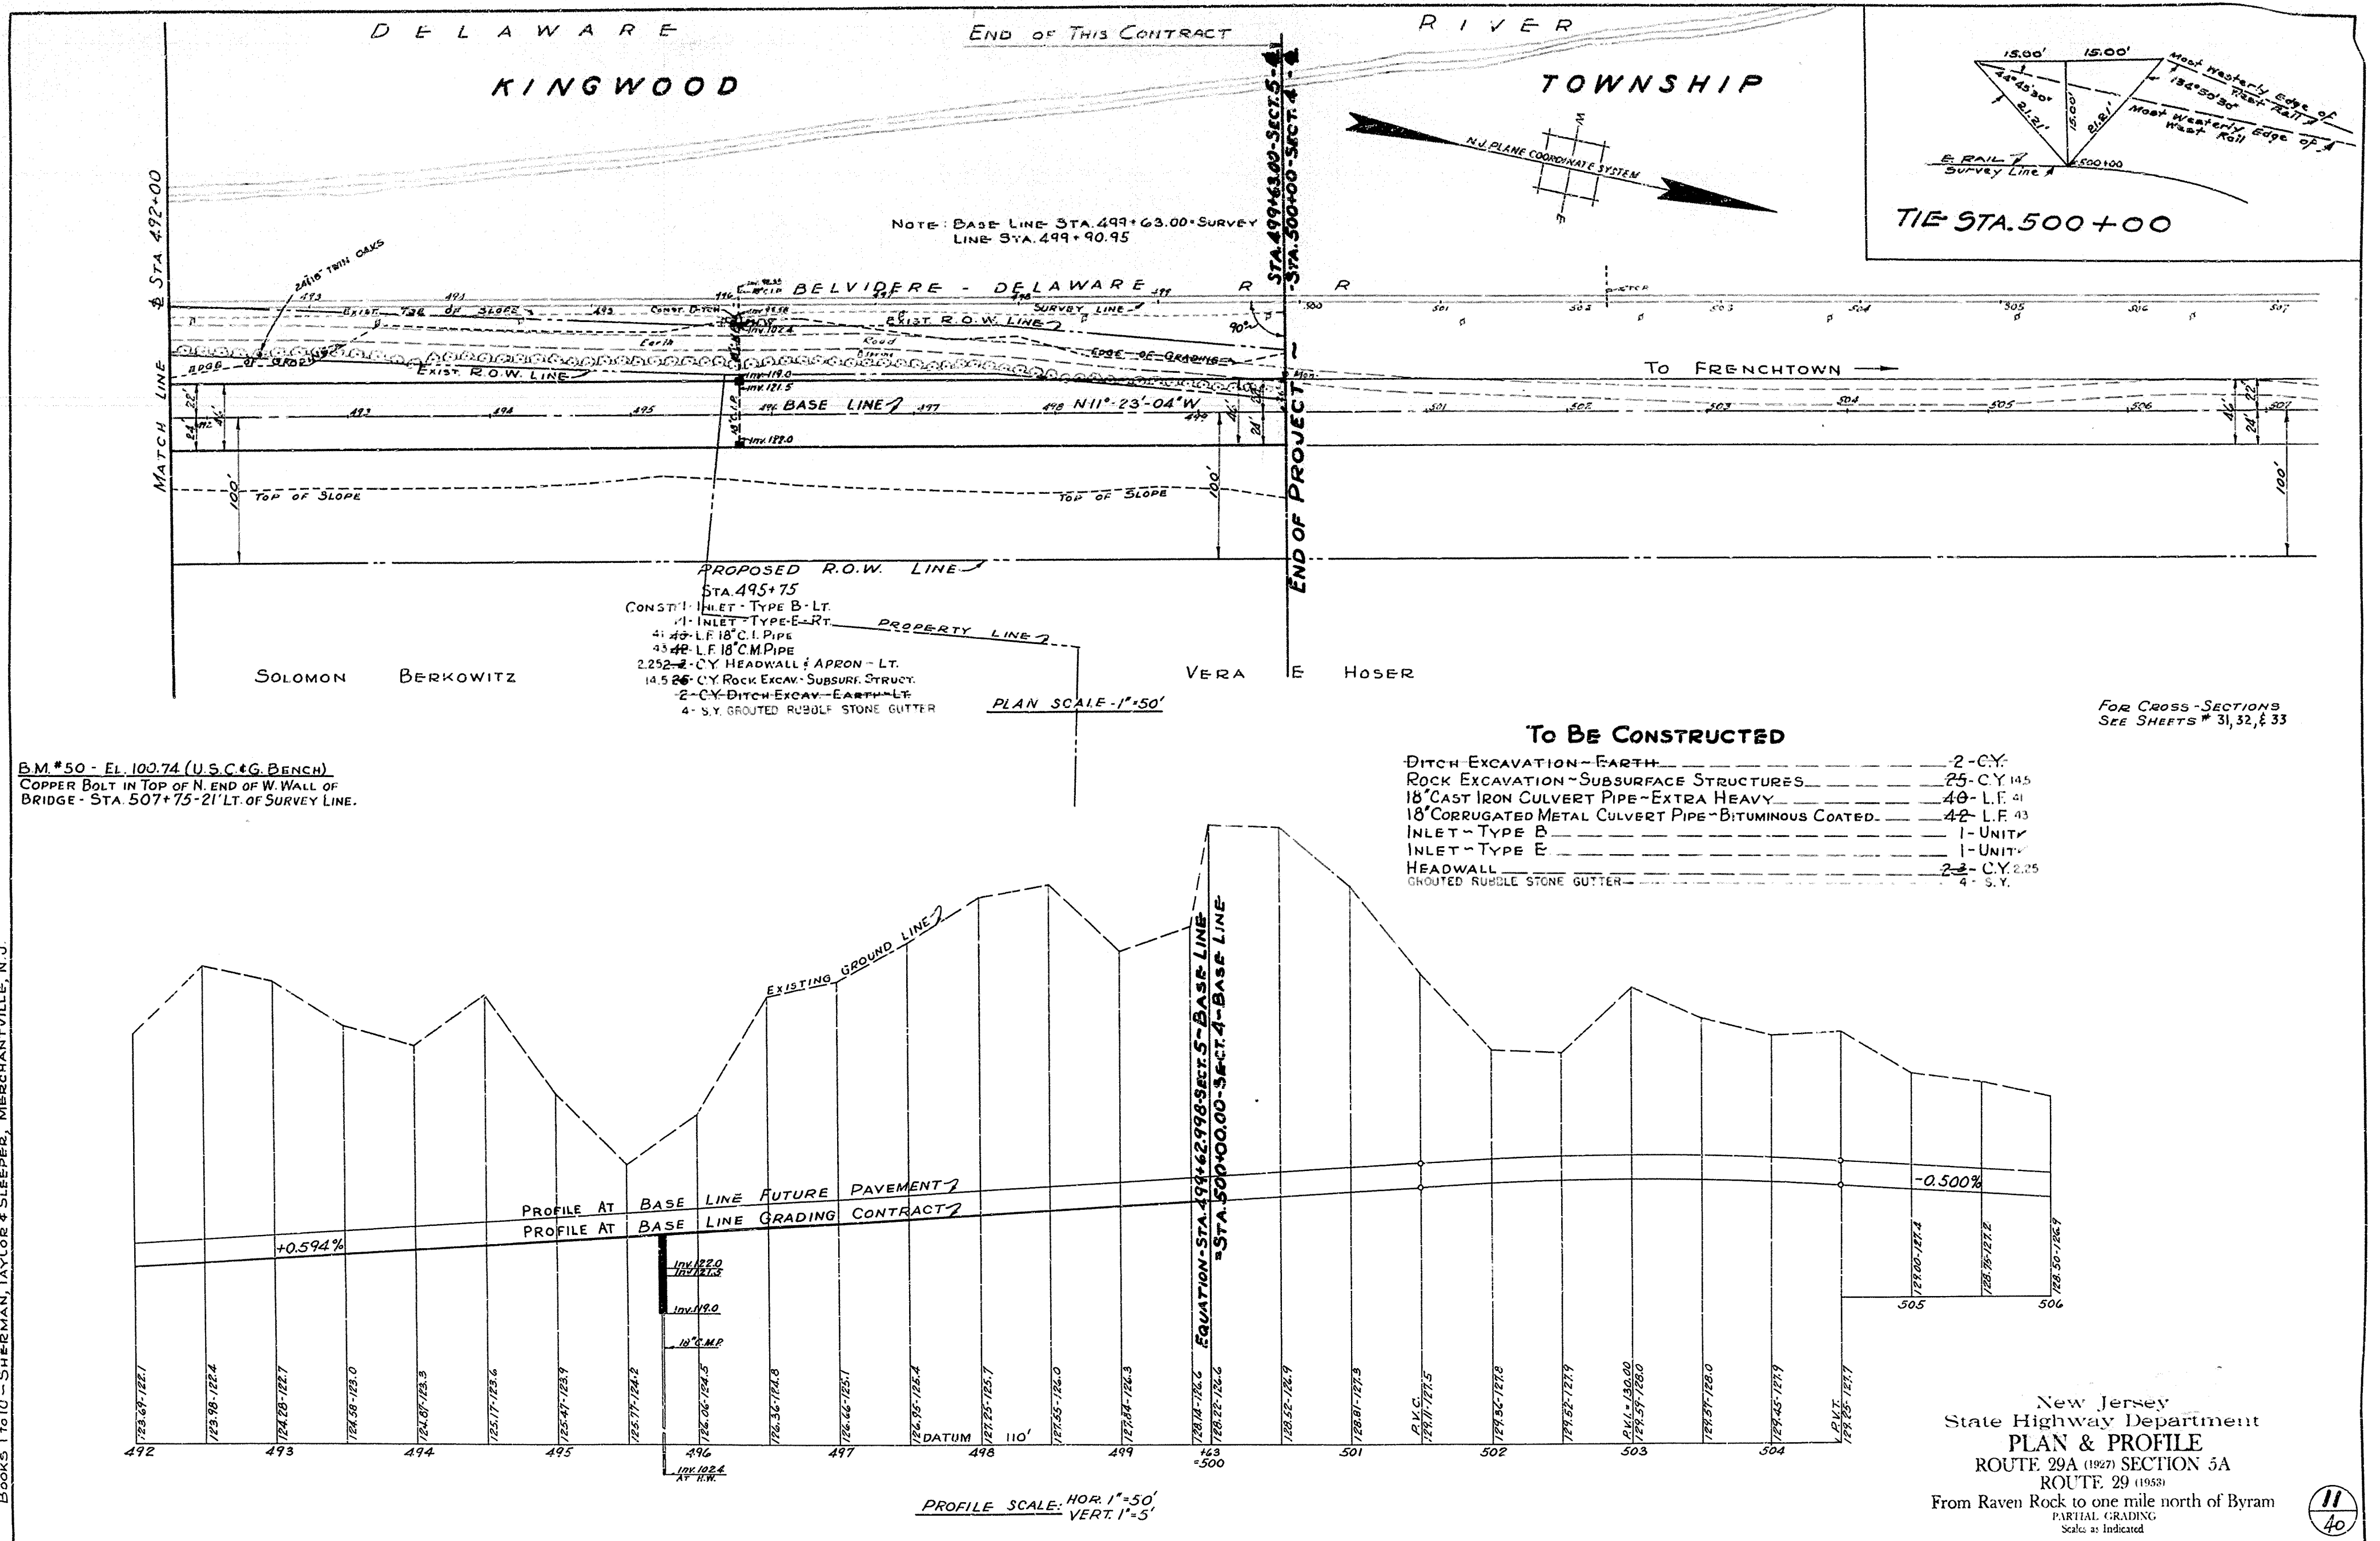

1008 011 040

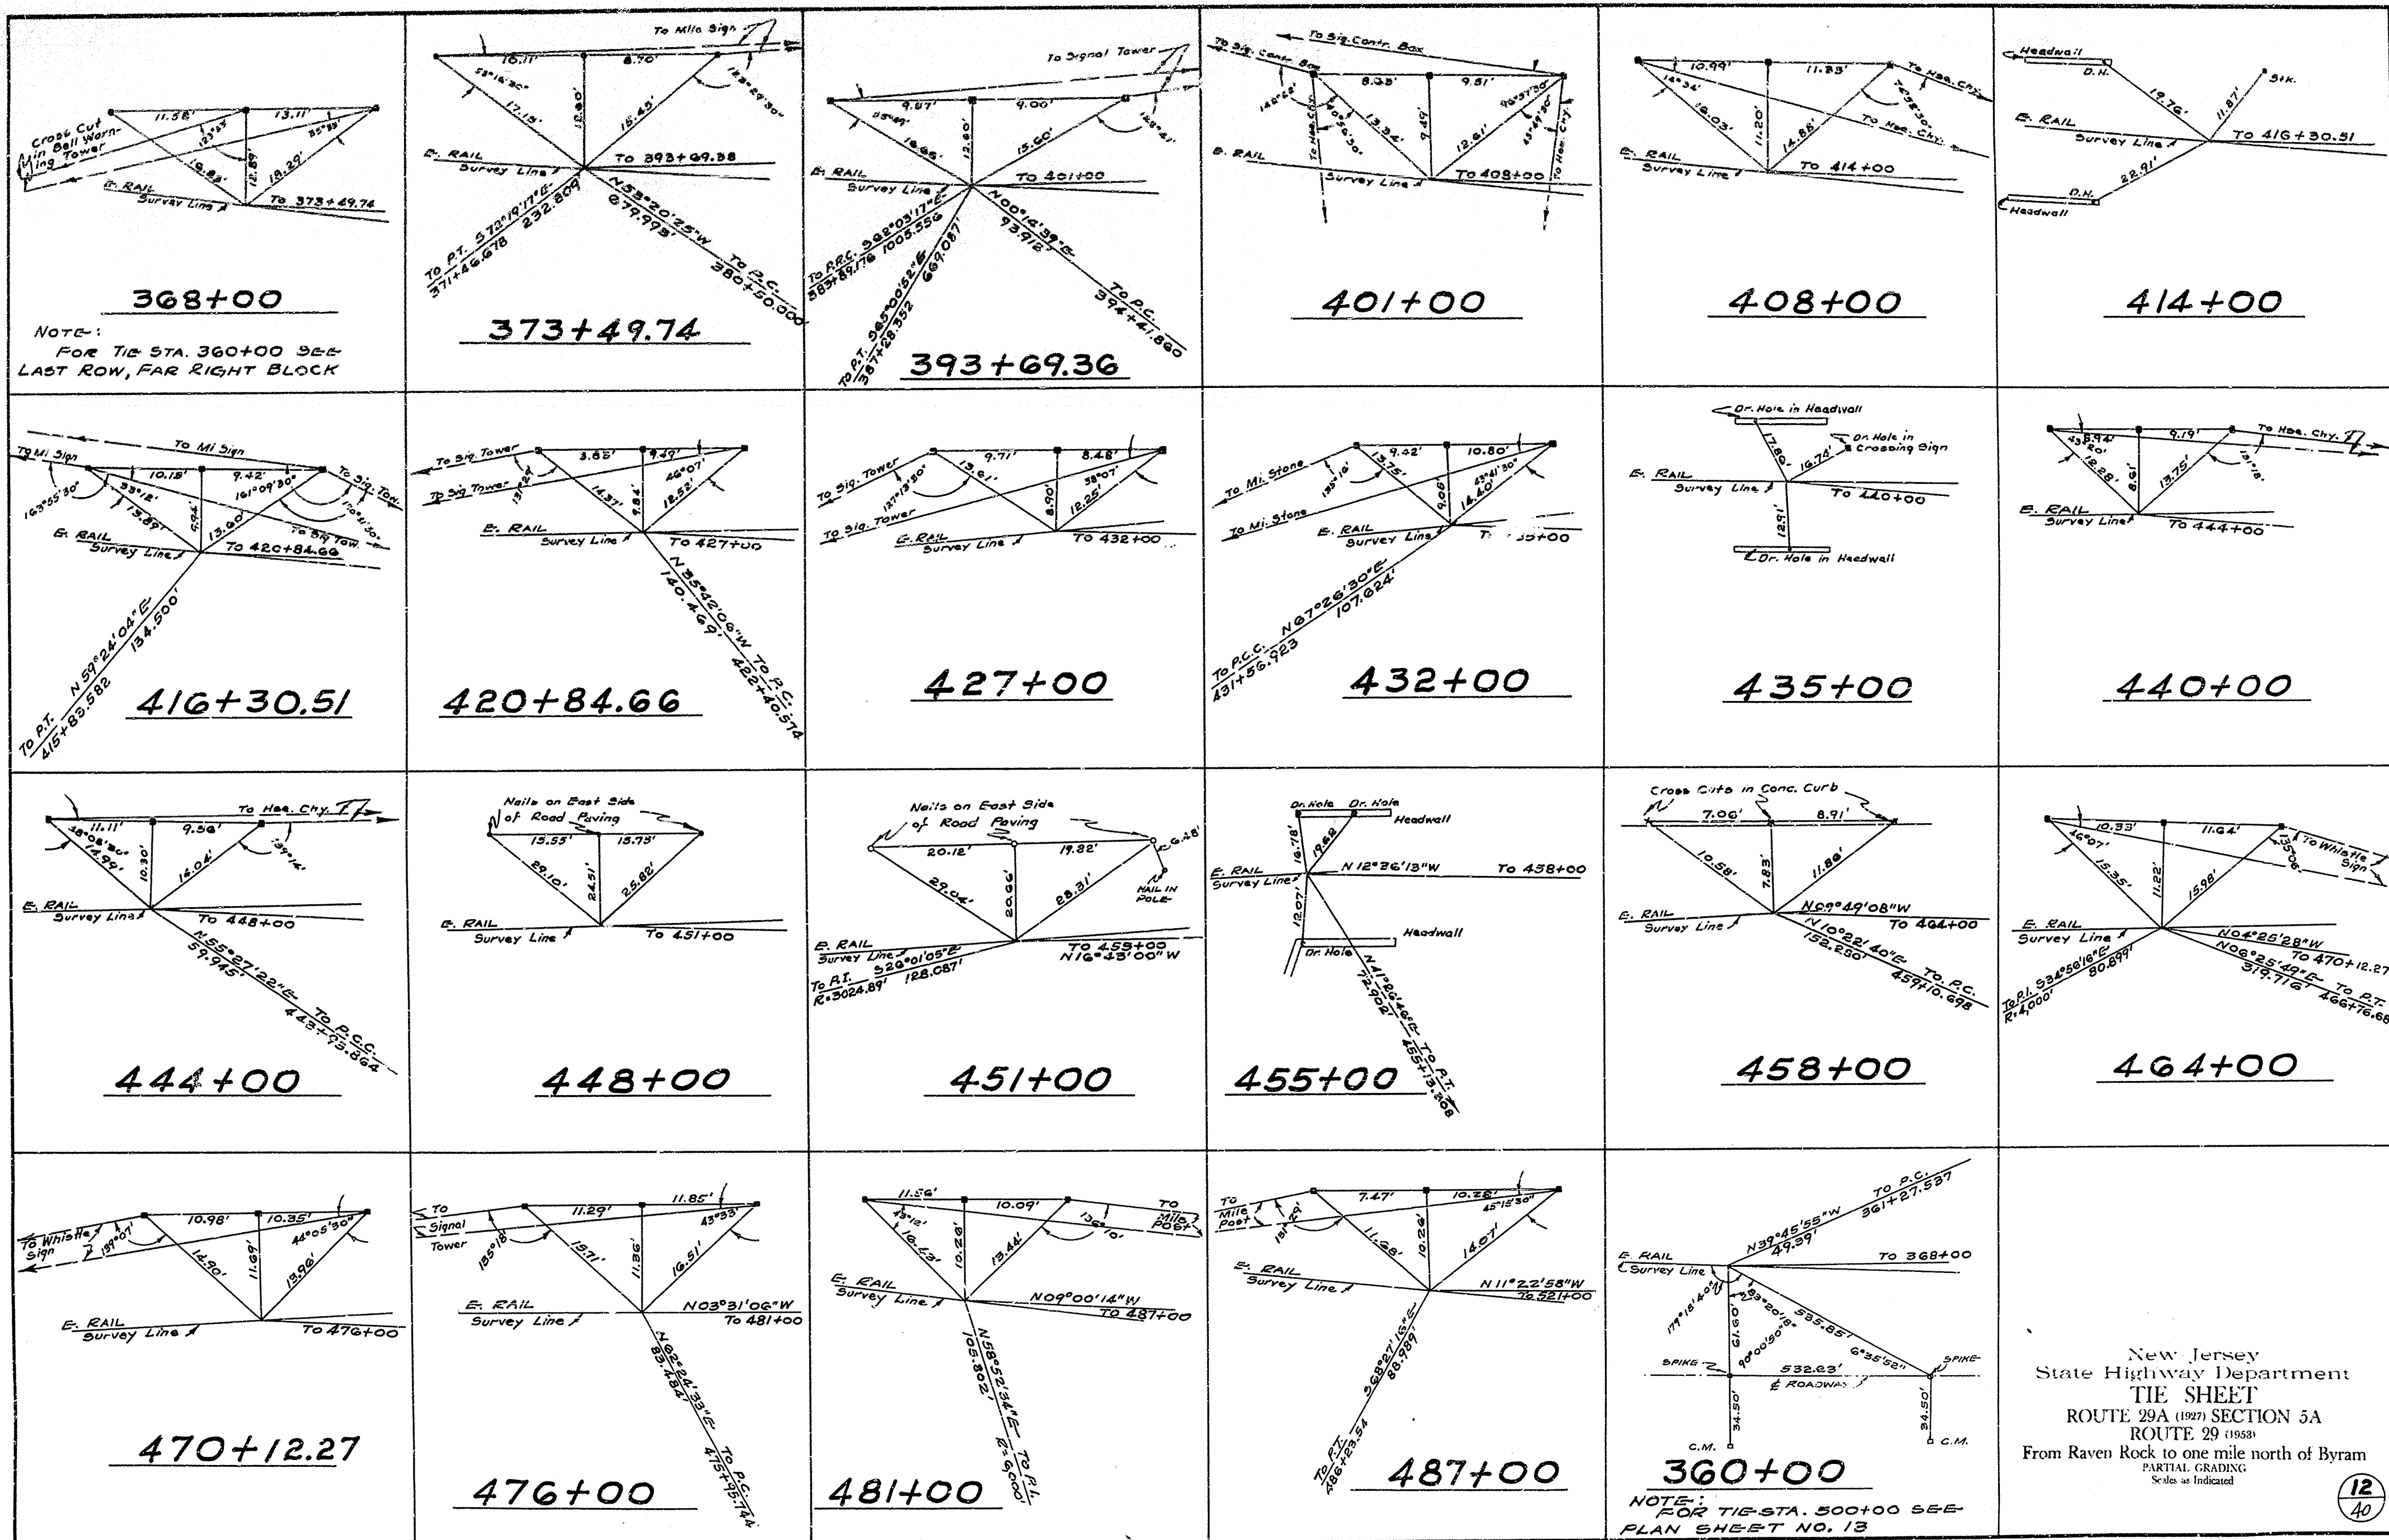

1008 012 040


STATE OF NEW JERSEY
HIGHWAY DEPARTMENT
PLANS OF
ROUTE 29A (1927) SECTIONS 5B & 4A
ROUTE 29 (1953)
From Byram to Kingwood Station
PAVING

Kingwood Township
Scales as Indicated

Hunterdon County
June 1955

As Built

INDEX	
NO	DESCRIPTION
1	KEY SHEET
2	ESTIMATE OF QUANTITIES
	TAKE OFF SHEET
	TYPICAL SECTIONS
3 - 6	PLANS
7	DETAIL SHEET

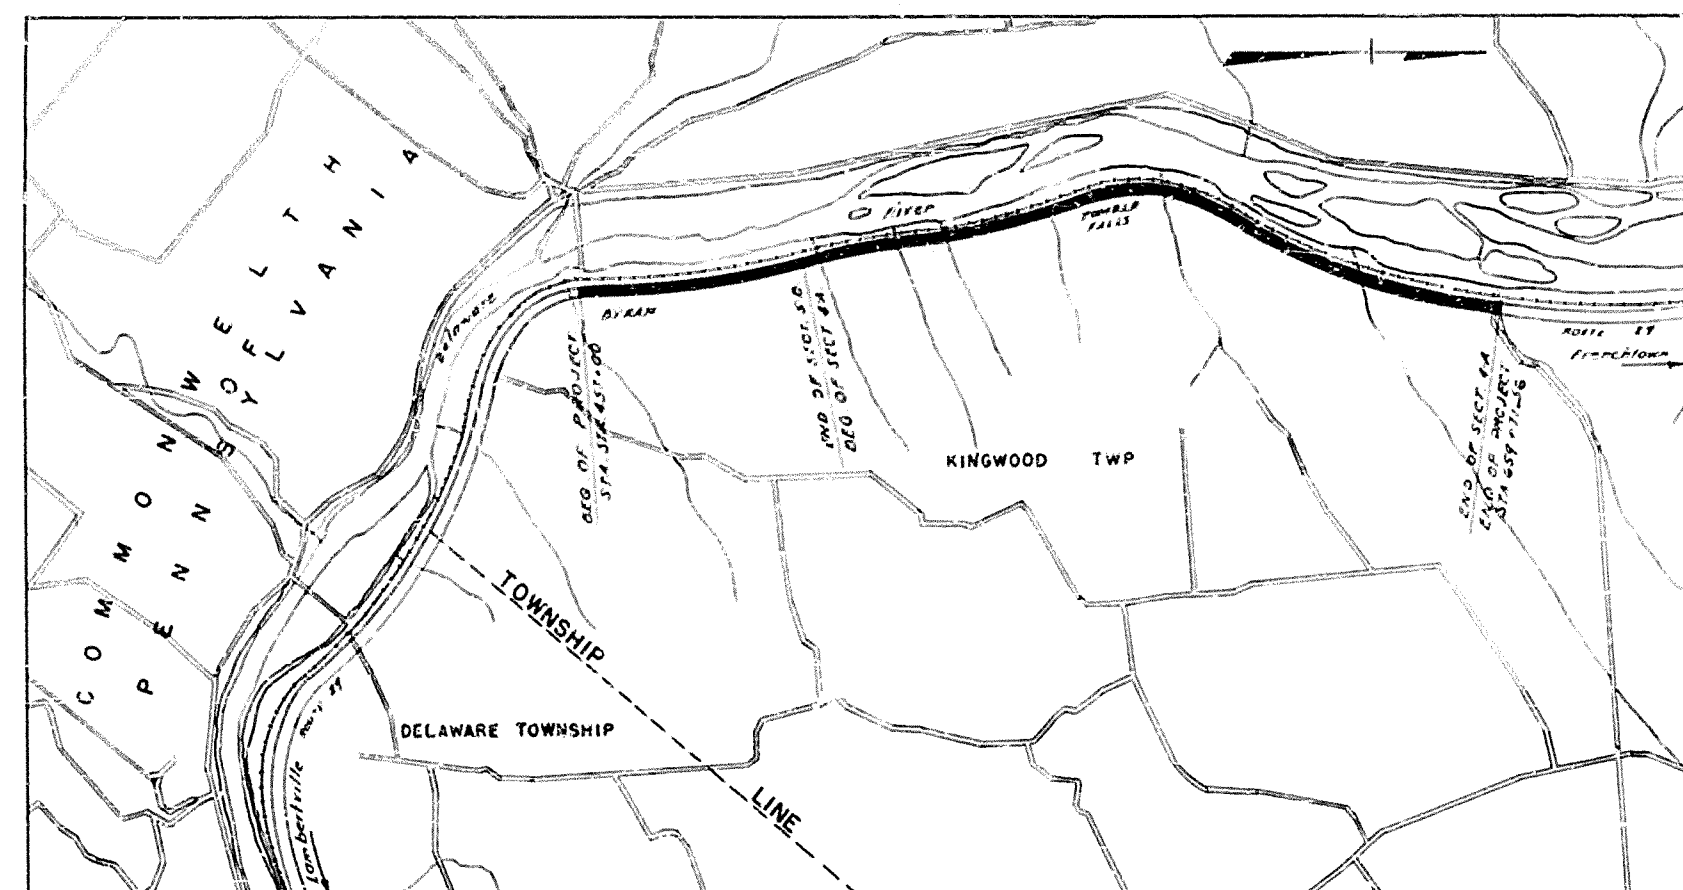

KEYMAP

SCALE 1" = 1/2 MILE

LENGTH OF PROJECT 20,235.03 LIN. FT. 3.832 MILES

STANDARD HIGHWAY SPECIFICATIONS OF 1941 TO GOVERN

Submitted by D. Hubert Cristoforo 6-10-55
Director & Chief Engineer
Division of Planning, Research, Soils & Tests
Approved by [Signature] 6-13-55
State Highway Engineer
Approved by [Signature]
State Highway Commissioner

1008 001 007

TYPICAL SECTIONS



Existing or Proposed Beam Guard Rail
Exist. Slopes
Prop. Gravel Shldr. - 3" Thk
Exist. Gravel Base
Exist. 8" Stabilized Gravel Base
Proposed Pen. Macadam Surface Course - 3" Thick

Sta. 459+10.70 to Sta. 499+63
Sta. 500+0 to Sta. 533+75
Sta. 541+50 to Sta. 548+50
Sta. 567+22 to Sta. 570+44
Sta. 620+35.12 to Sta. 633+75

Existing or Proposed Beam Guard Rail
Exist. Slopes
Prop. Gravel Shldr. - 3" Thk
Exist. Gravel Base
Exist. 8" Stabilized Gravel Base
Proposed Pen. Macadam Surface Course - 3" Thick

Sta. 534+75 to Sta. 540+67
Sta. 549+50 to Sta. 565+92
Sta. 634+45 to Sta. 658+20

Existing or Proposed Beam Guard Rail
Exist. Slopes
Prop. Gravel Shldr. - 3" Thk
Exist. Gravel Base
Exist. 8" Stabilized Gravel Base
Proposed Pen. Macadam Surface Course - 3" Thick

Sta. 586+08 to Sta. 612+53

VARIABLE SECTIONS	
Sta. 457+00	to Sta. 459+10.70
Sta. 533+75	to Sta. 534+75
Sta. 540+67	to Sta. 541+50
Sta. 548+50	to Sta. 549+50
Sta. 565+92	to Sta. 567+22
Sta. 570+44	to Sta. 586+08
Sta. 612+53	to Sta. 620+35.12
Sta. 633+75	to Sta. 634+45
Sta. 658+20	to Sta. 659+71.56

Scale - 1" = 3'


<u>VARIABLE SECTIONS</u>	
Sta. 457+00	to Sta. 459 +10.70
Sta. 533+75	to Sta. 534 +75
Sta. 540+67	to Sta. 541 + 50
Sta. 548 + 50	to Sta. 549 + 50
Sta. 565+92	to Sta. 567 + 22
Sta. 570+44	to Sta. 586 +08
Sta. 612 +53	to Sta. 620 +35.12
Sta. 633+75	to Sta. 634 + 45
Sta. 658+20	to Sta. 659+ 71.56

Scale - 1" = 3'

[illegible]

New Jersey
State Highway Department
ESTIMATE OF QUANTITIES
TAKE OFF SHEET
TYPICAL SECTIONS
ROUTE 29A (1927) SECTIONS 5B & 4A
ROUTE 29 (1953)
From Byram to Kingwood Station
PAVING
Scales as Indicated

1008 002 007

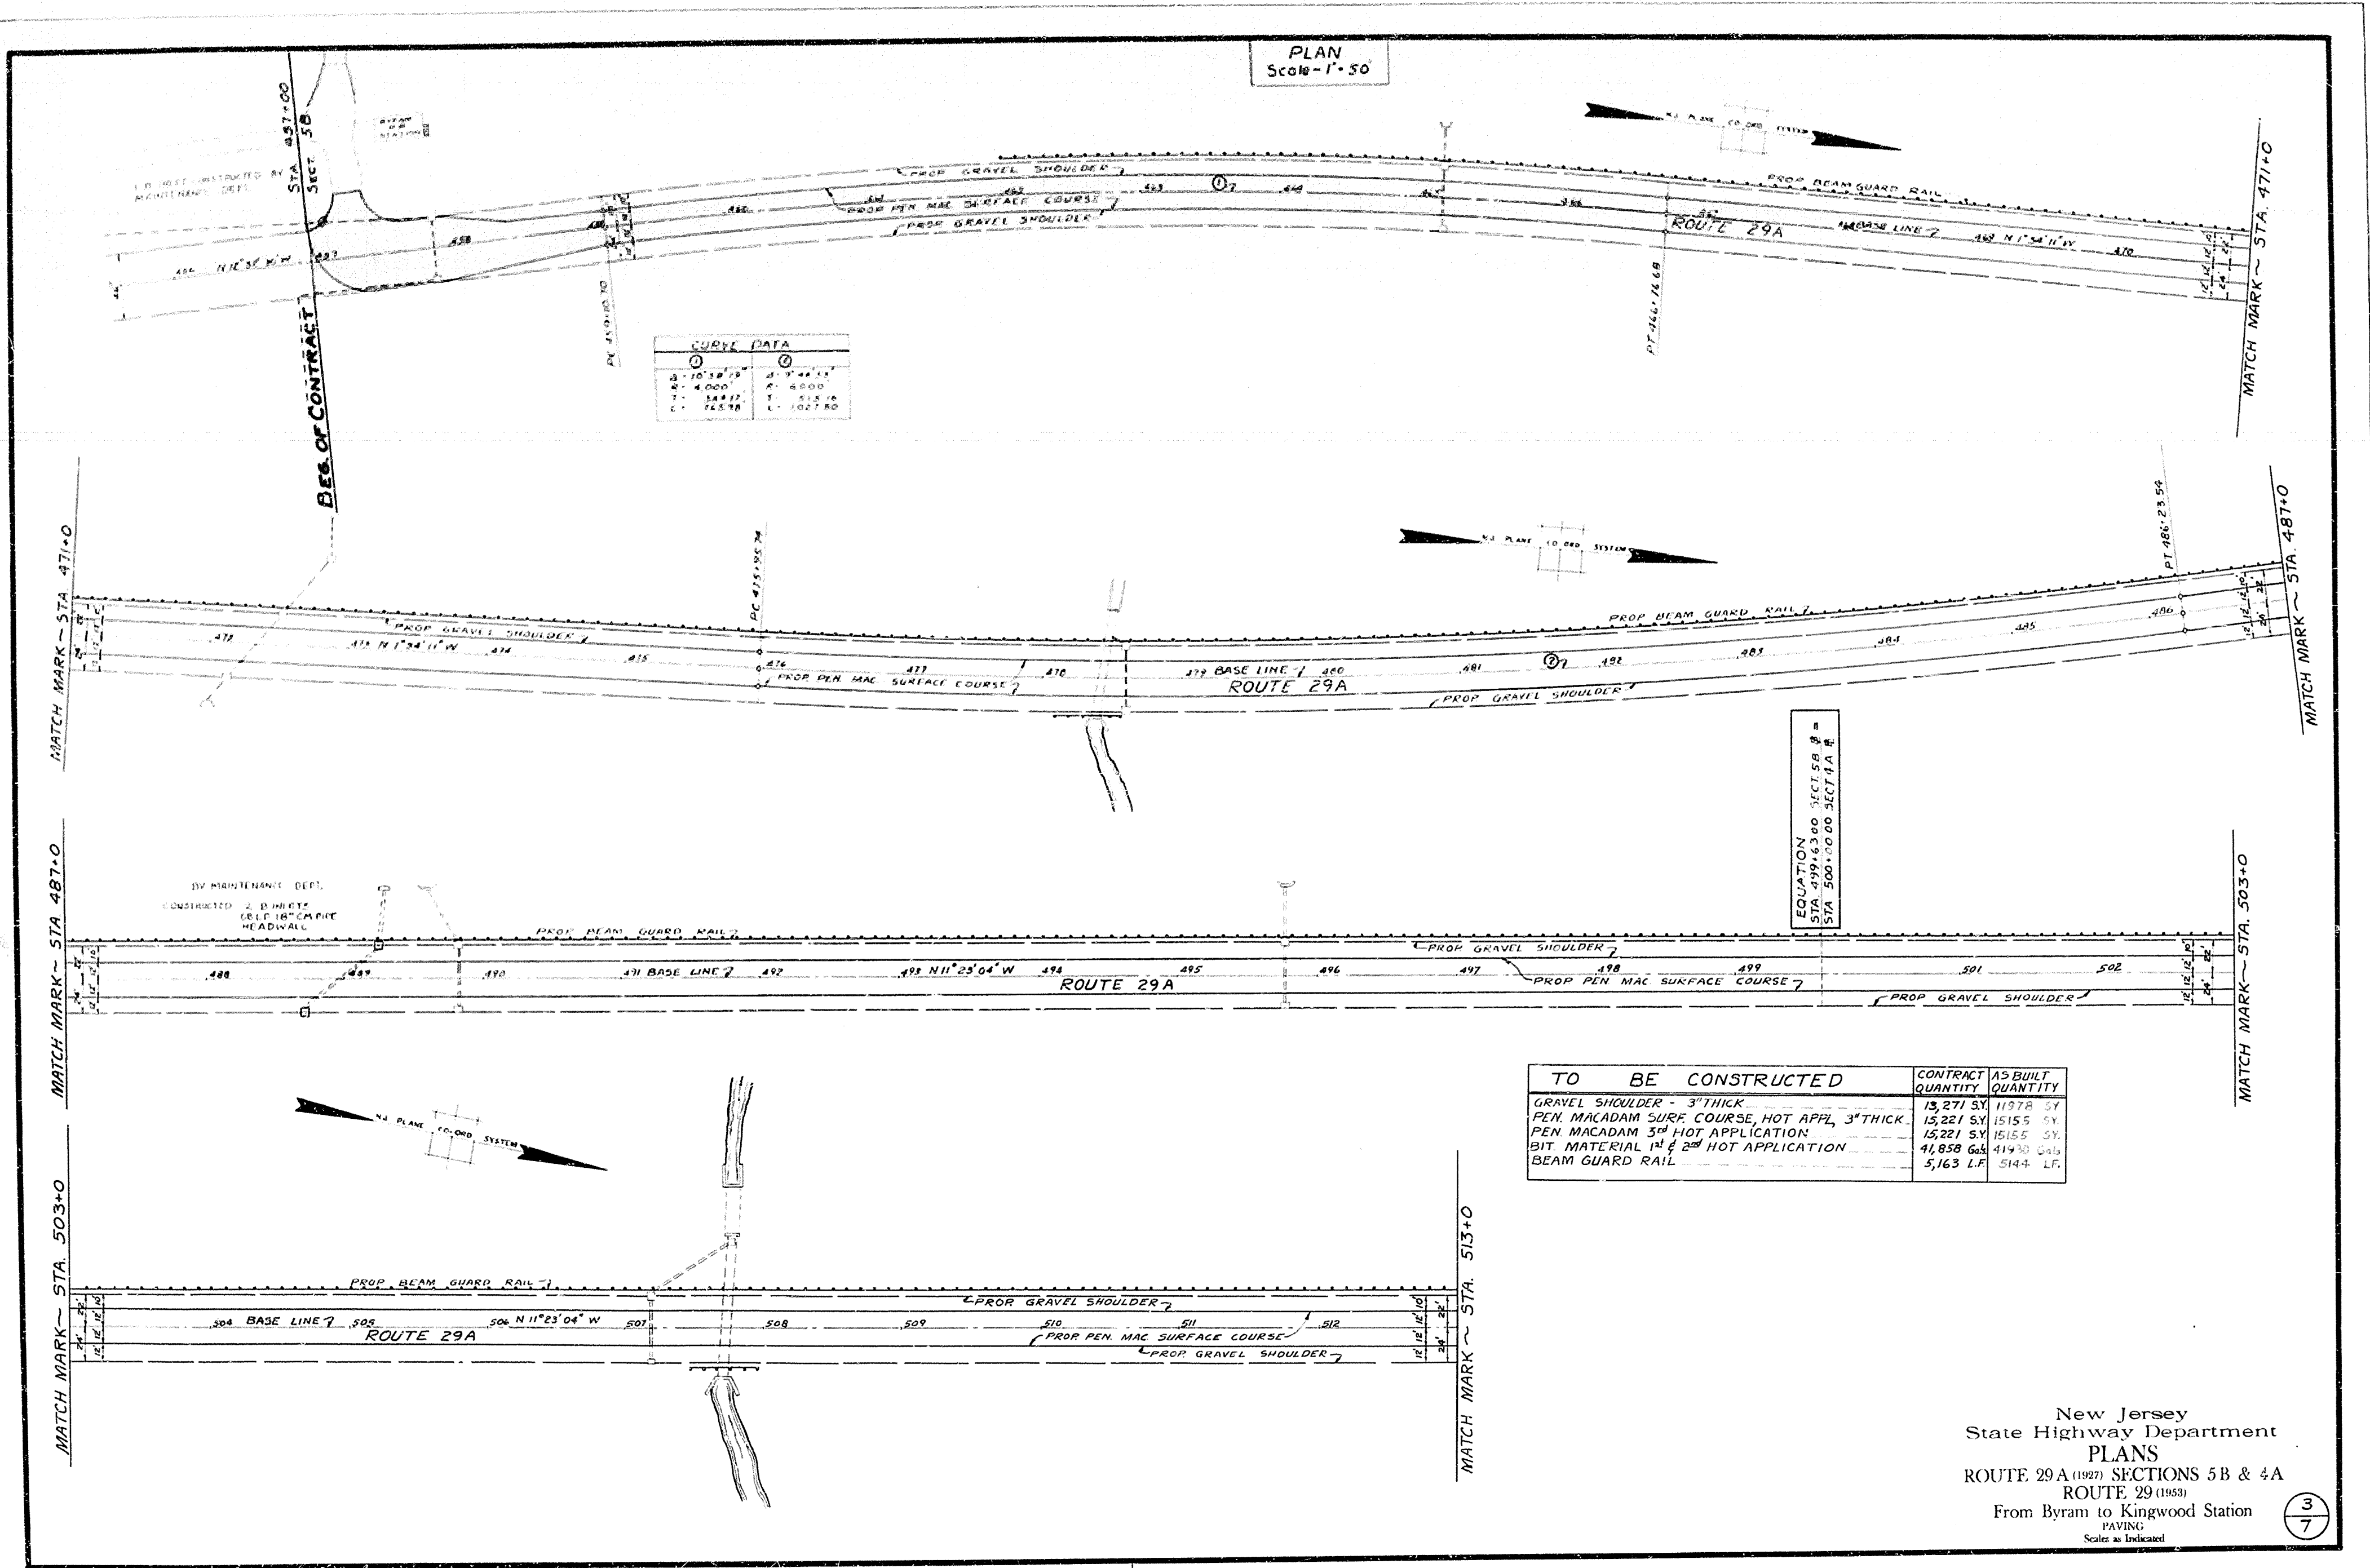


New Jersey
State Highway Department
PLANS
ROUTE 29A (1927) SECTIONS 5B & 4A
ROUTE 29 (1953)
From Byram to Kingwood Station
PAVING
Scales as Indicated

1008 003 007

PLAN
Scale - 1" = 50'


CURVE DATA			
①	②	③	④
Δ 4°00'04"	Δ 0°52'32"	Δ 3°32'12"	Δ 8°01'28"
R 9,000'	R 3,000'	R 9,500'	R 2,600'
T 524.06'	T 234.55'	T 464.91'	T 675.76'
L 649.44'	L 460.71'	L 929.07'	L 1,348.32'

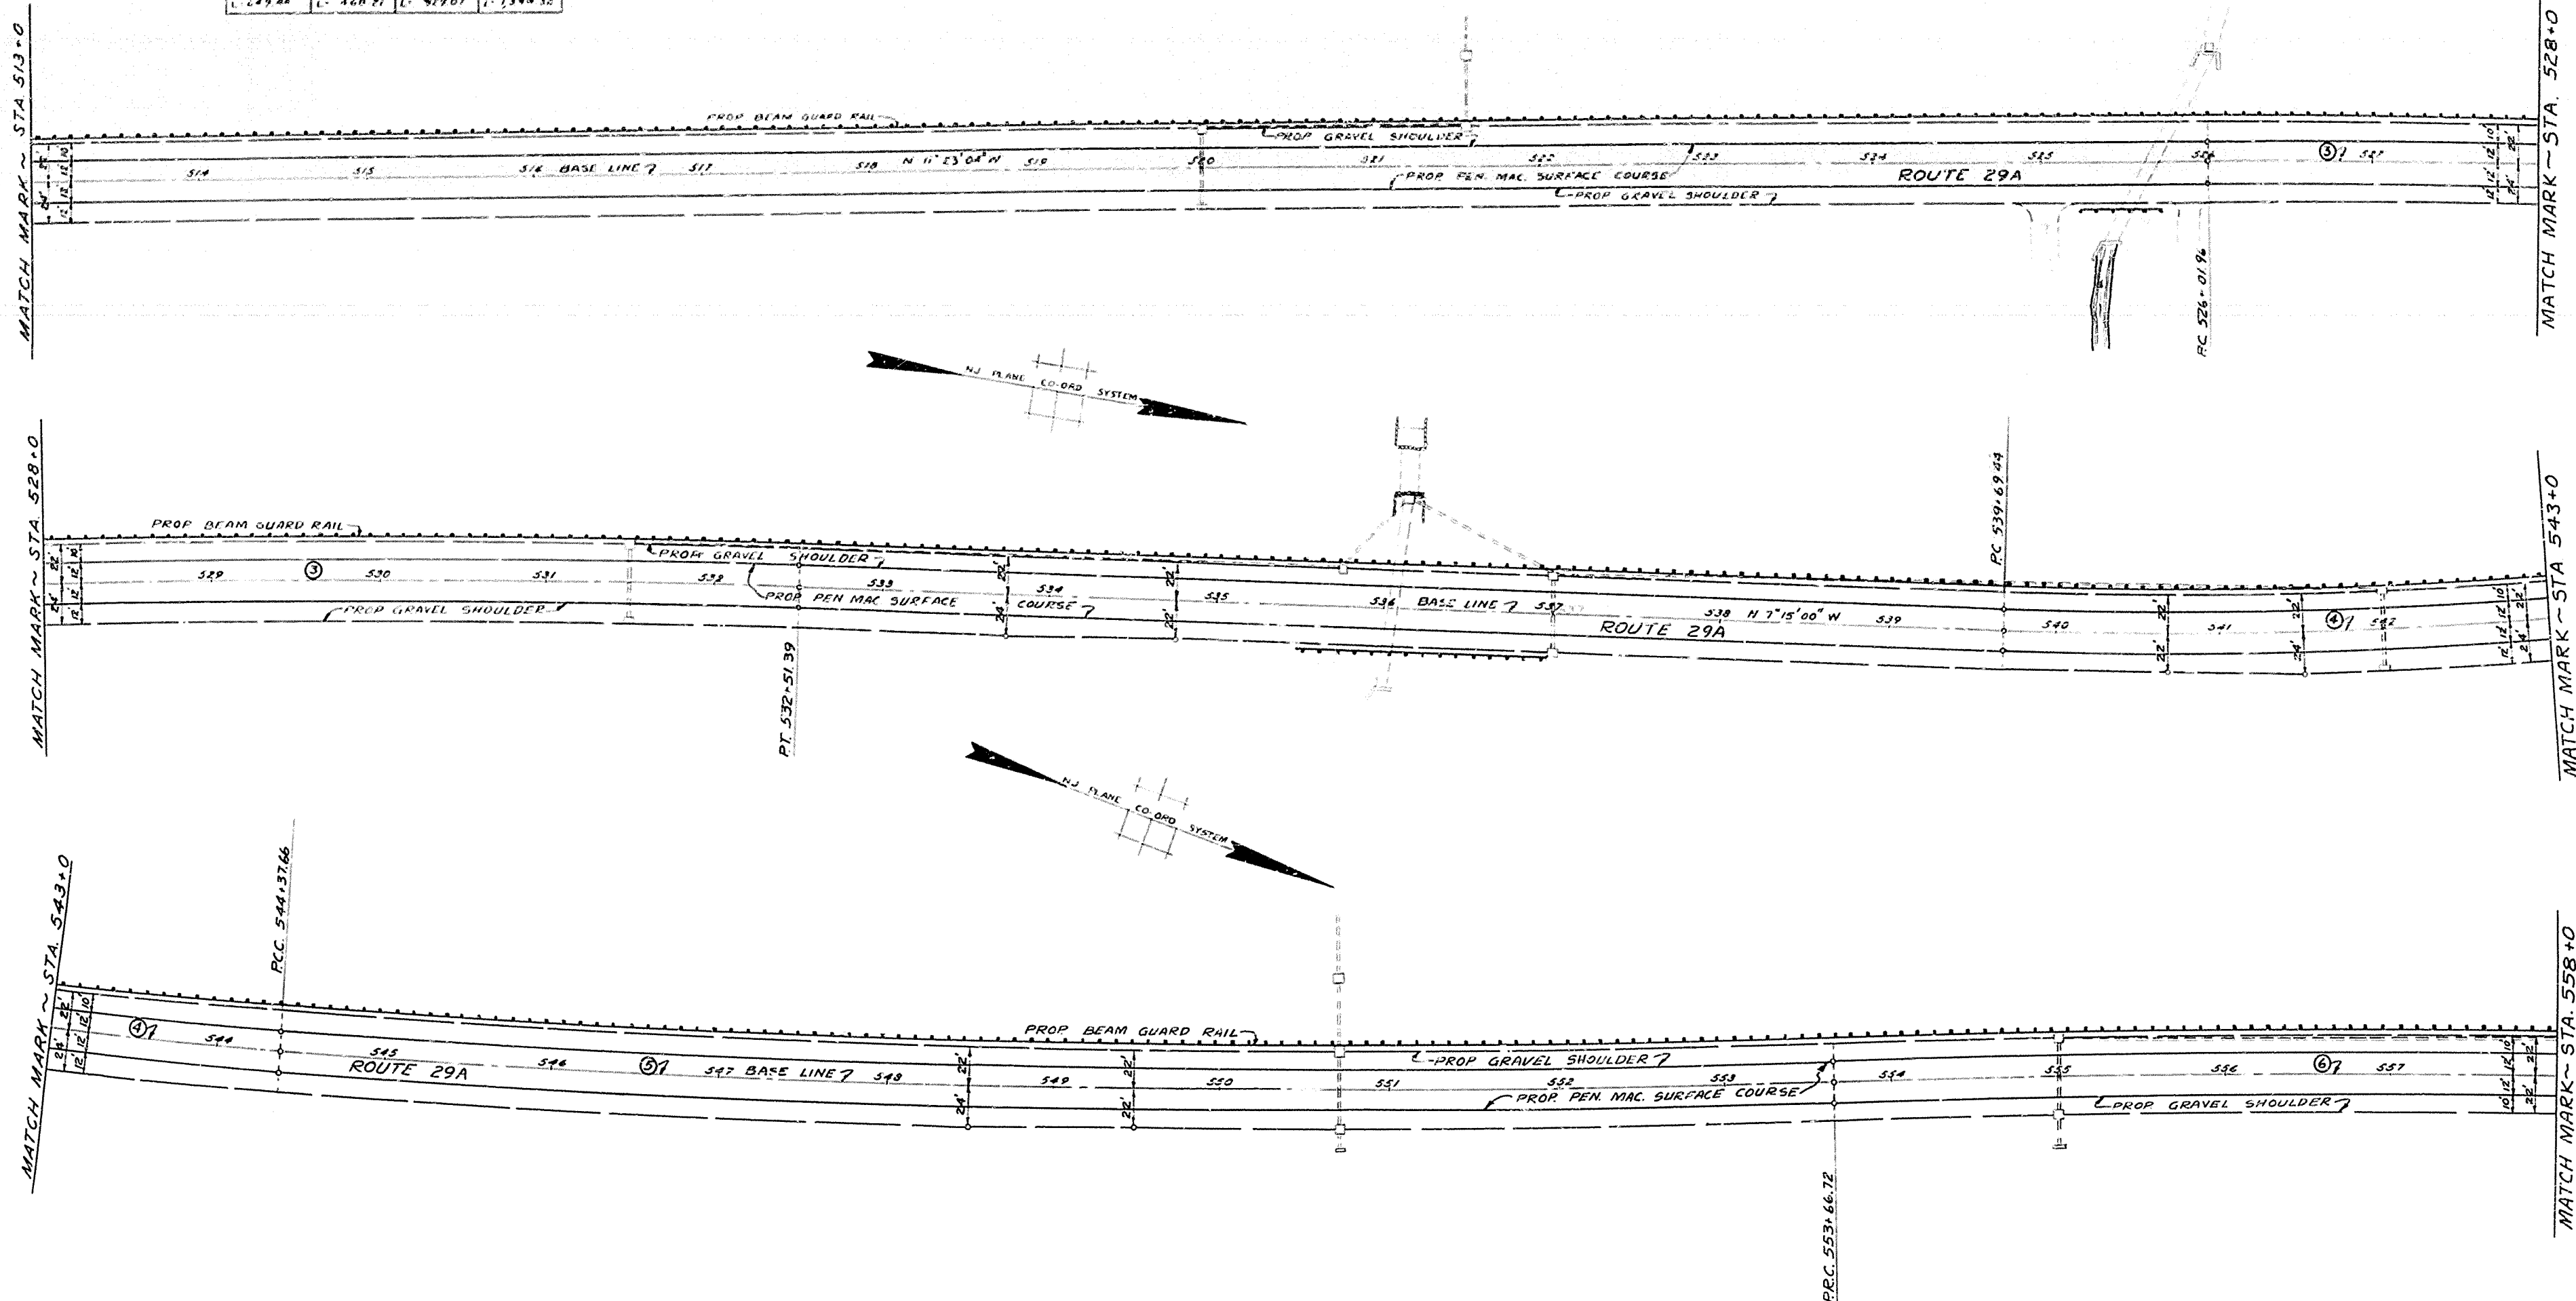

TO BE CONSTRUCTED	CONTRACT QUANTITY	AS BUILT QUANTITY
GRAVEL SHOULDER - 3" THICK	10,648 SY	9825 SY
PEN. MACADAM SURF COURSE, HOT APPL., 3" THICK	12,000 SY	12,002 SY
PEN. MACADAM 3 rd APPLICATION	12,000 SY	12,002 SY
BIT MATERIAL 1 st & 2 nd HOT APPLICATION	33,000 Gals	33,207 Gals
BEAM GUARD RAIL	4,700 LF	4,690 LF

New Jersey
State Highway Department
PLANS
ROUTE 29 A (1927) SECTIONS 5B & 4A
ROUTE 29 (1953)
From Byram to Kingwood Station
PAVING
Scales as Indicated

1008 004 007

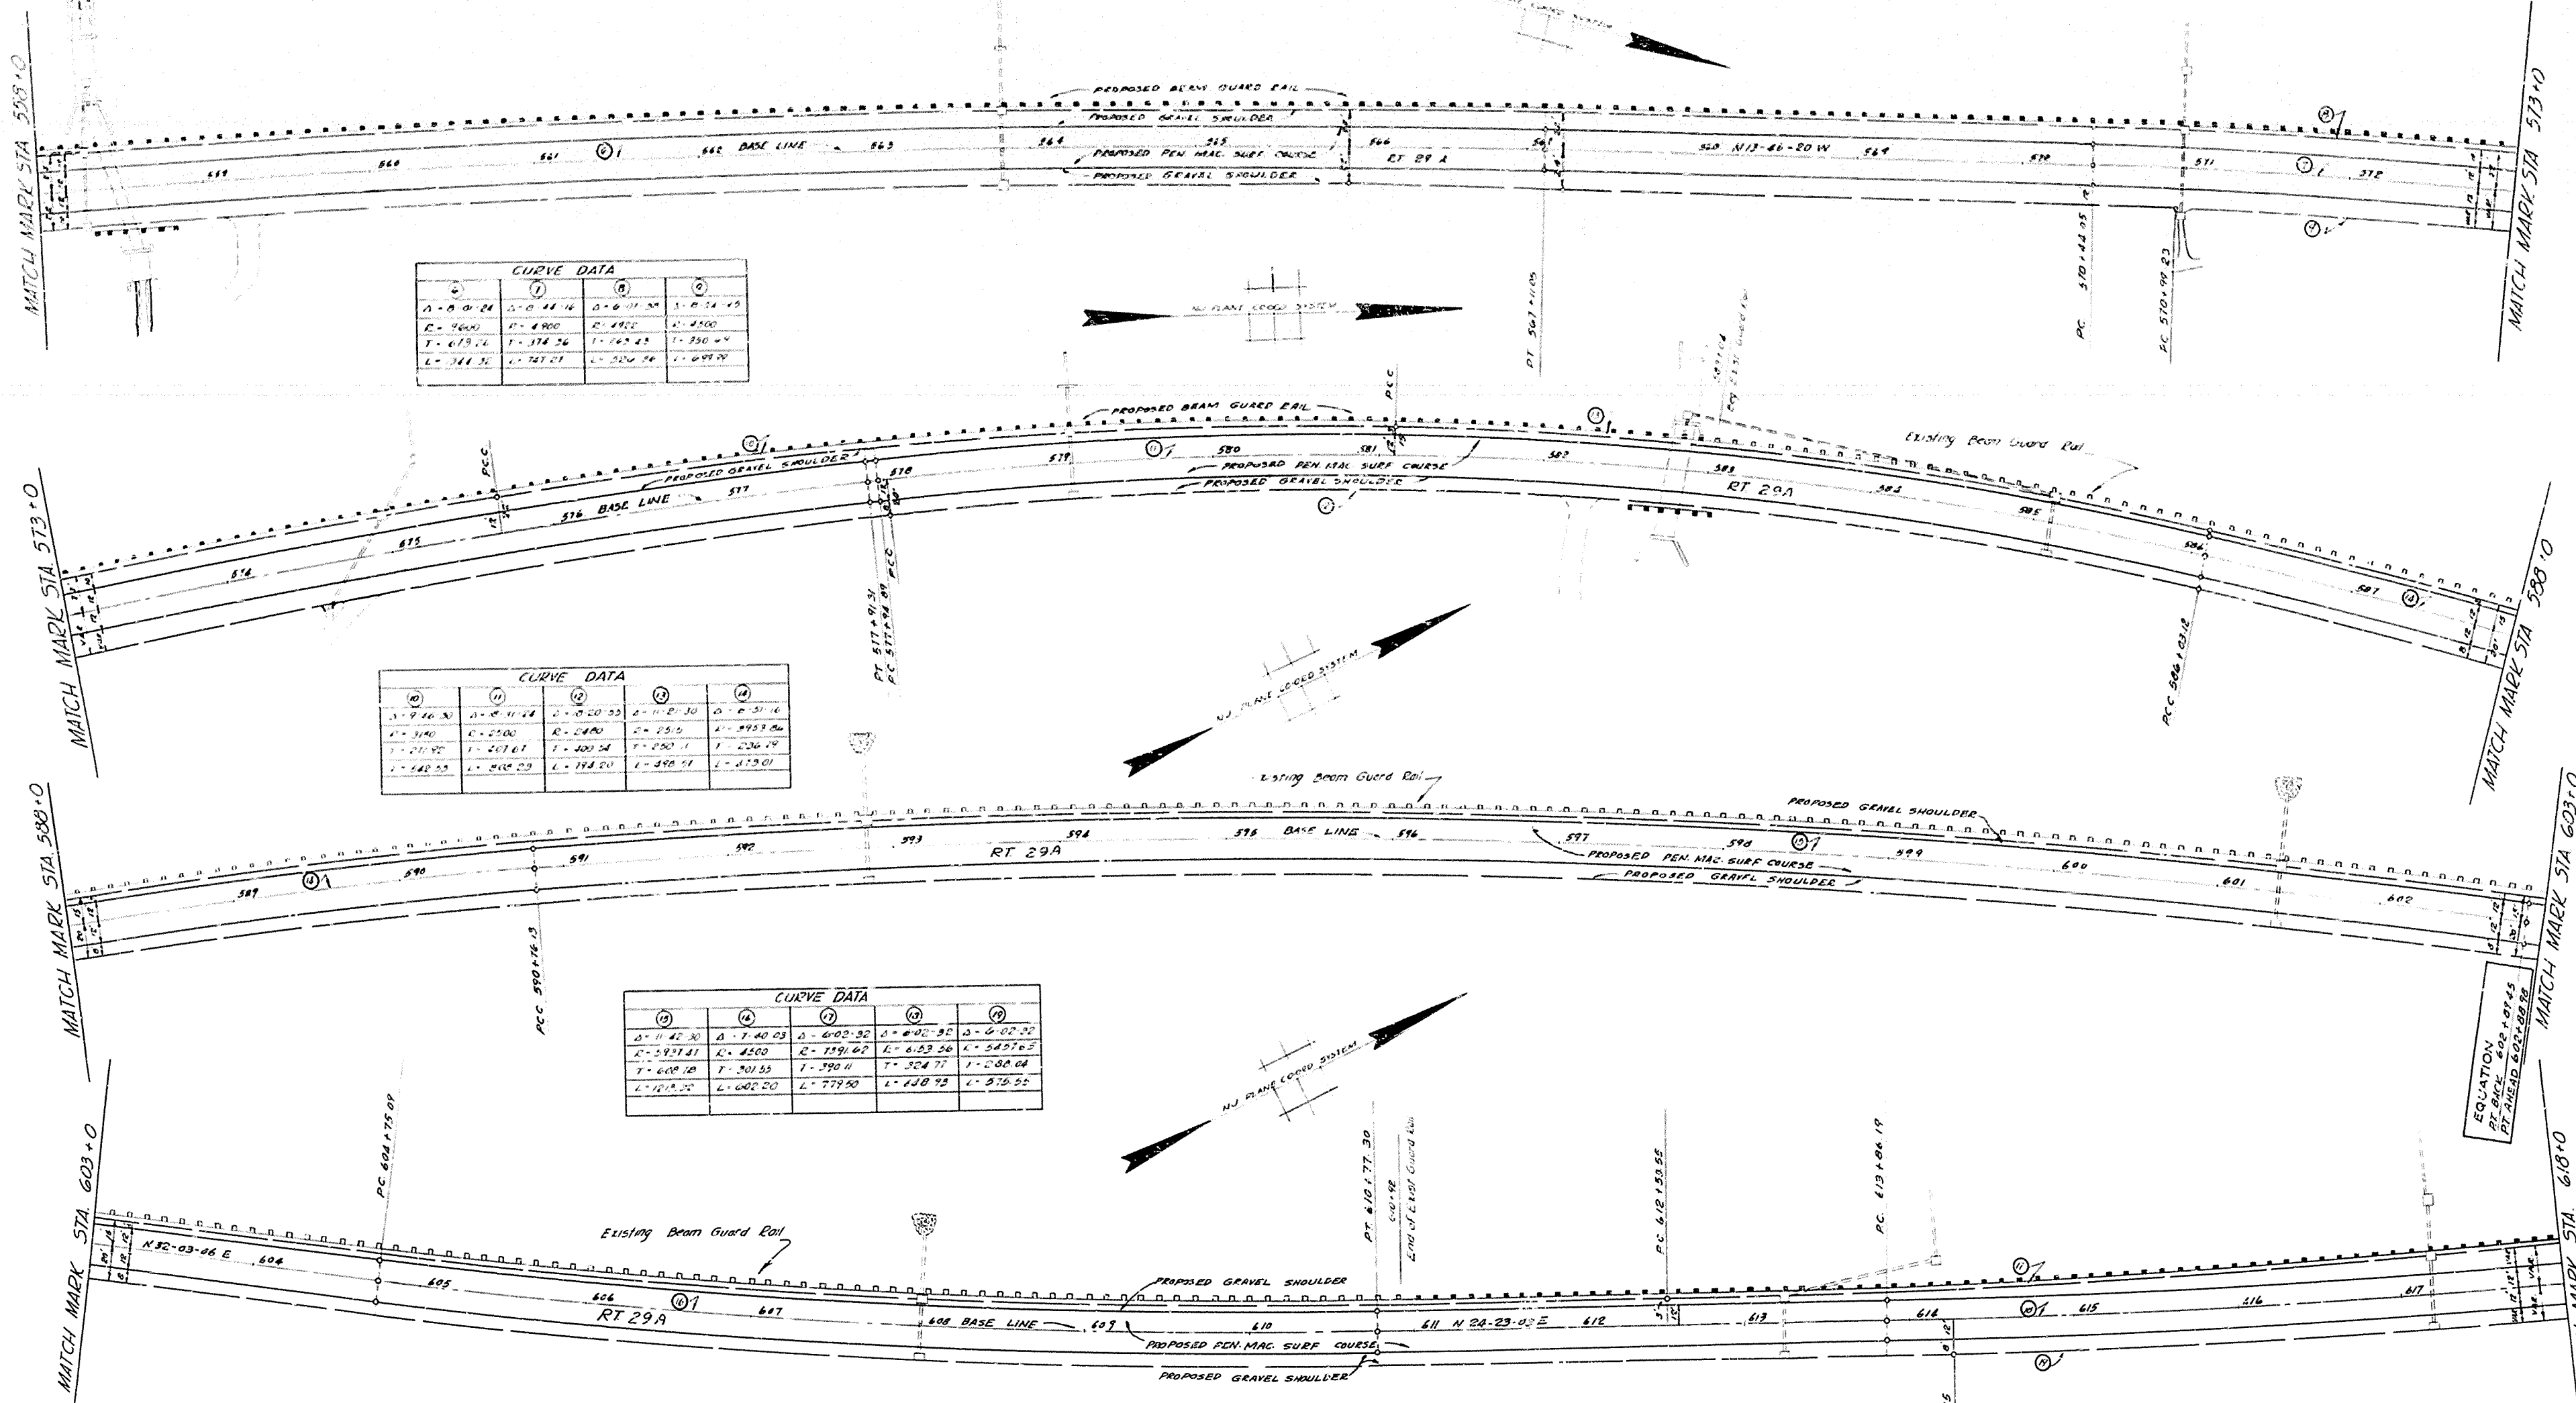

CURVE DATA				


TO BE CONSTRUCTED		CONTRACT QUANTITY	AS QUANT QUANTITY
GRAVEL SHOULDER 3" THICK		9,954 SY	10232 SY
PEN. MACADAM SURF COURSE HOT APPL. 3" TH		16,000 SY	16,003 SY
BIT. MATERIAL 1st & 2nd HOT APPL		44,000 gals	44,276 gals
PEN. MACADAM 3rd HOT APPL		16,000 SY	16,003 SY
BEAM GUARD RAIL		3312 LF	3345 LF

New Jersey
State Highway Department
PLANS
ROUTE 29A (1927) SECTIONS 5B & 4A
ROUTE 29 (1953)
From Byram to Kingwood Station
PAVING
Scales as Indicated

1008 005 007

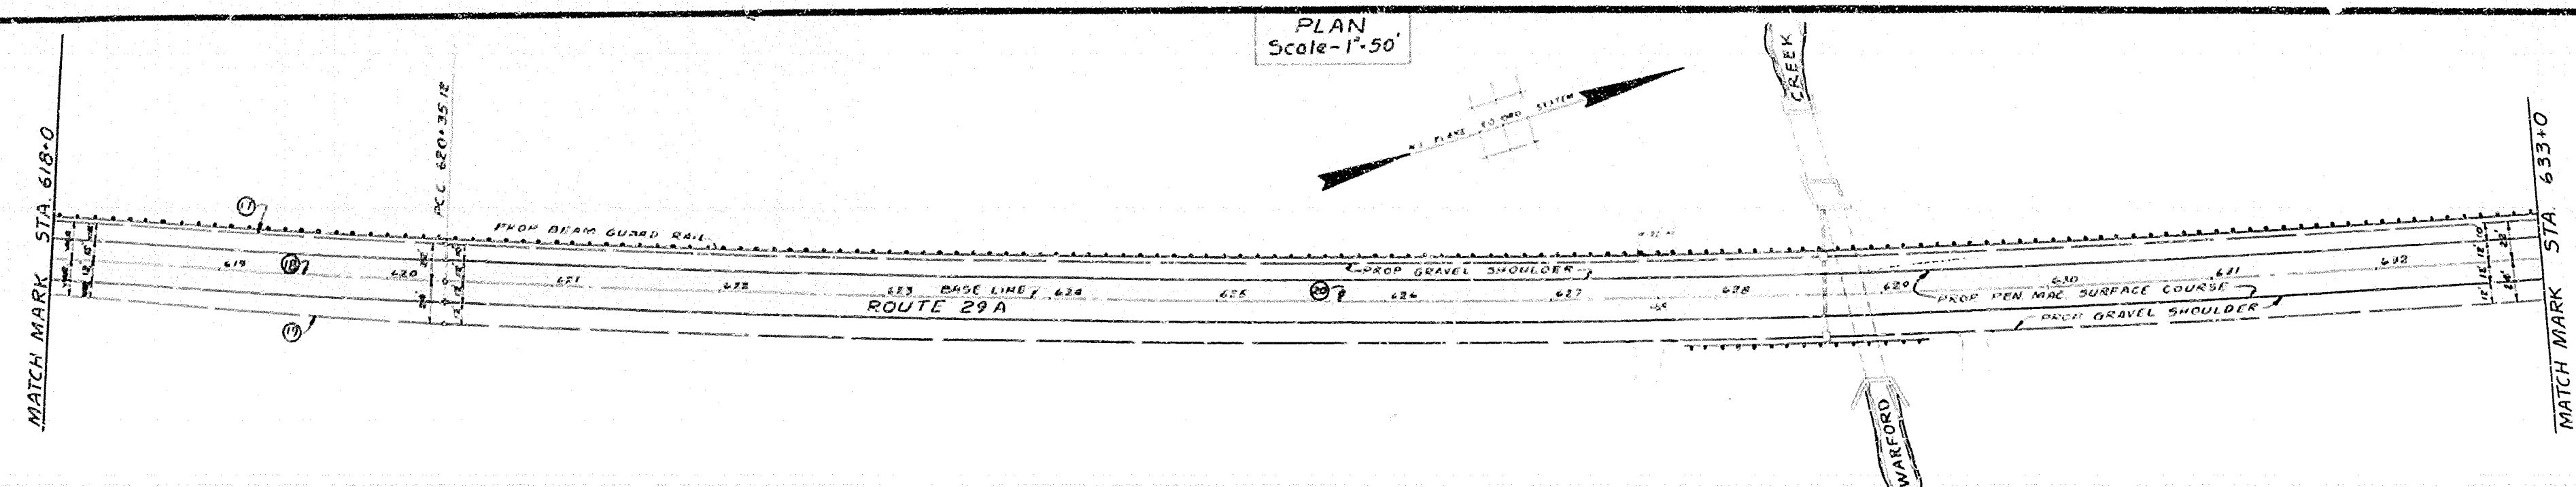

CURVE DATA			
(1)	(2)	(3)	(4)
$\Delta: 6^{\circ} 02' 32''$	$\Delta: 6^{\circ} 02' 32''$	$\Delta: 6^{\circ} 02' 32''$	$\Delta: 9^{\circ} 50' 00''$
$R: 1391.62'$	$R: 1153.56'$	$R: 3457.65'$	$R: 10,000.00'$
$T: 390.11'$	$T: 324.17'$	$T: 288.04'$	$T: 860.23'$
$L: 779.50'$	$L: 648.93'$	$L: 575.55'$	$L: 1716.24'$

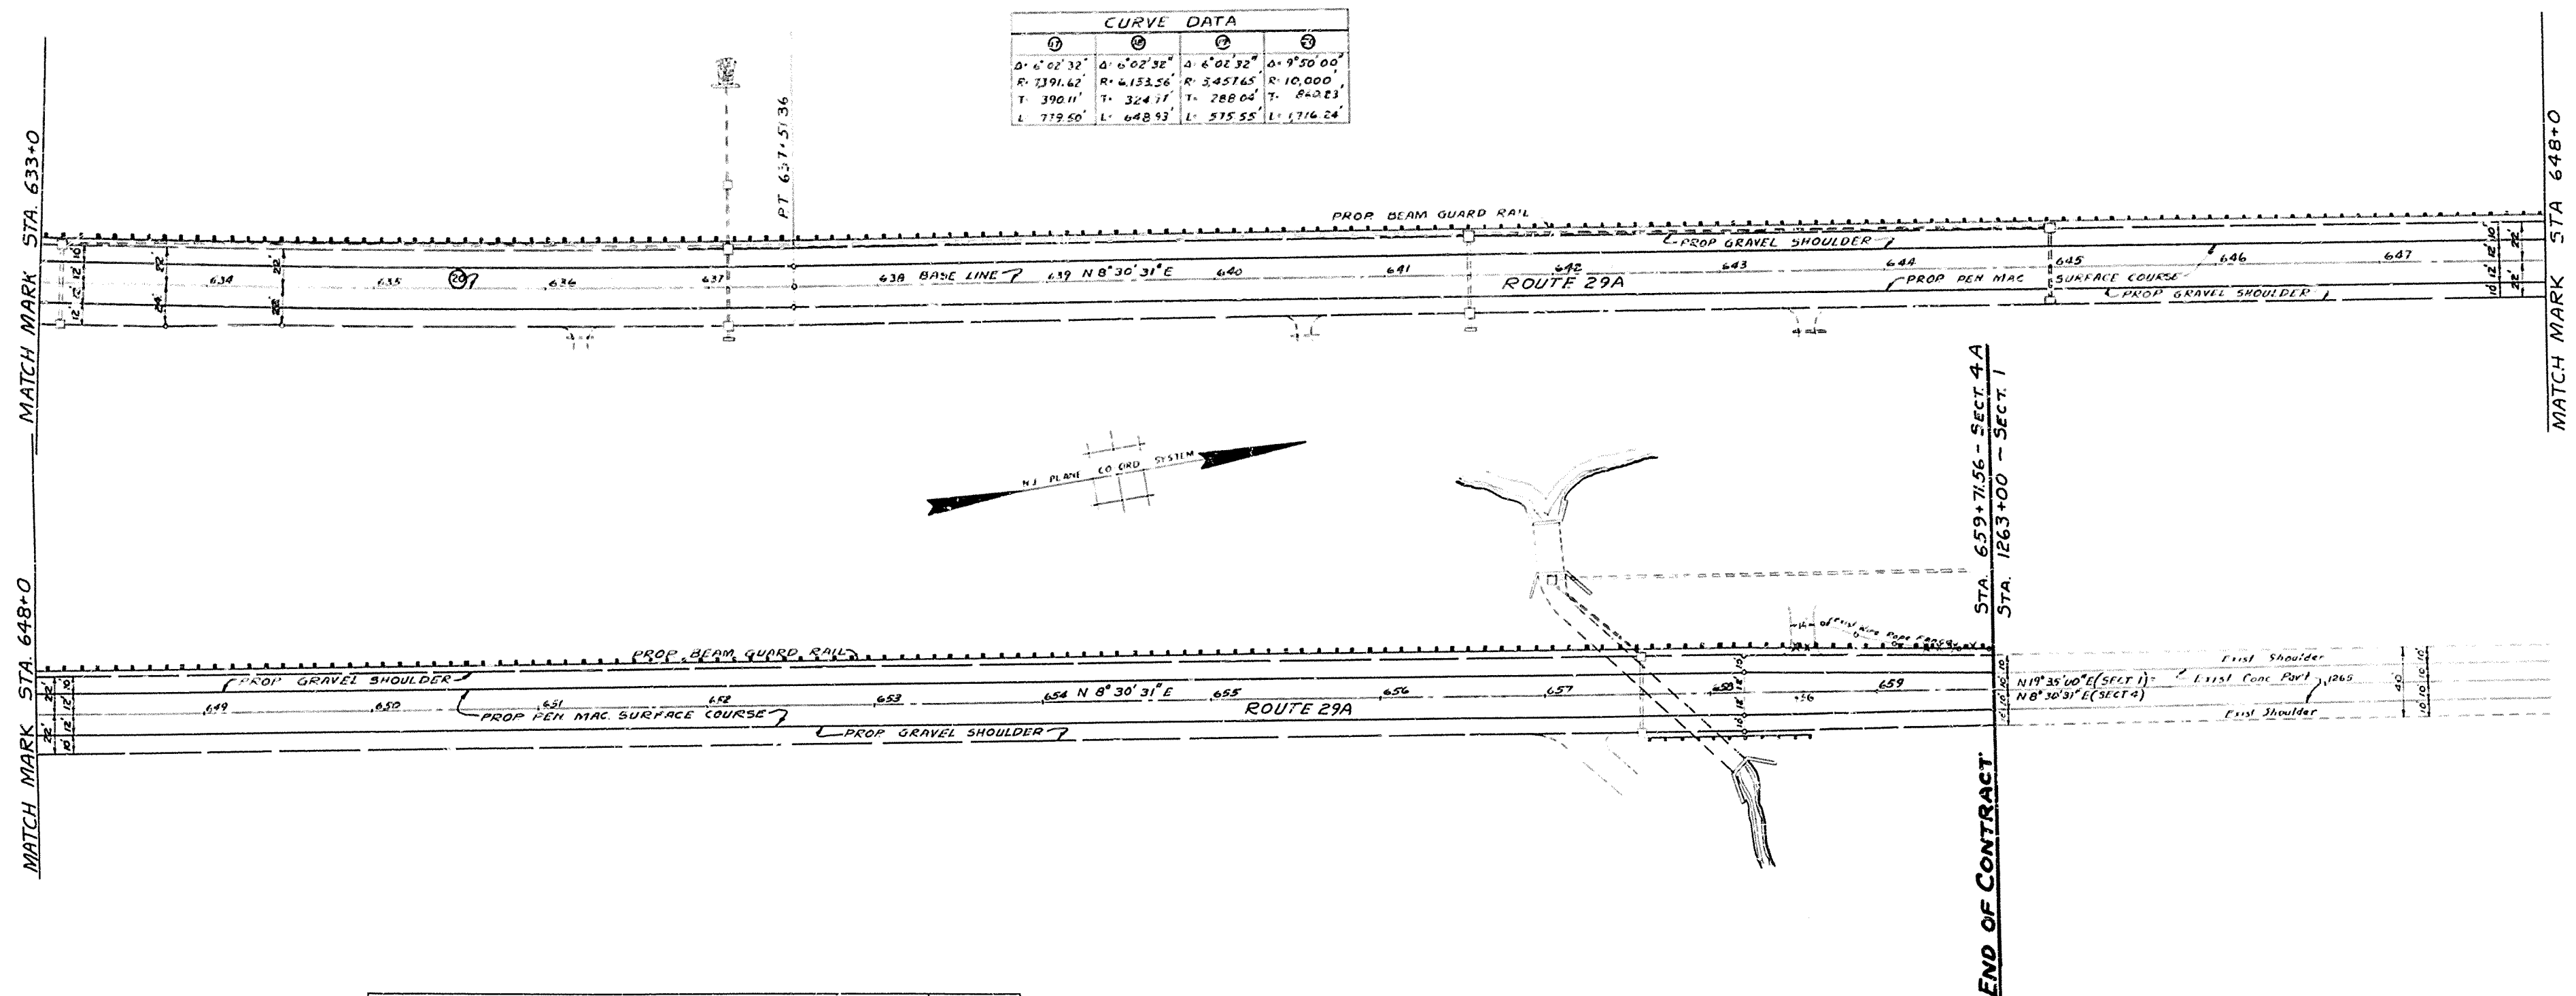

TO BE CONSTRUCTED	CONTRACT QUANTITY	AS BUILT QUANTITY
GRAVEL SHOULDER 3" THICK	9,577 SY	9028 SY
PEN. MACADAM SURF COURSE, HOT APPL., 3" THICK	11,091 SY	11093 SY
PEN. MACADAM 3" APPLICATION	11,091 SY	11093 SY
BIT. MATERIAL, 1 st 2 nd HOT APPLICATION	30,499 Gals	30708 Gals
BEAM GUARD RAIL	4,422 LF	4285 LF

New Jersey
State Highway Department
PLANS
ROUTE 29 A (1927) SECTIONS 5 B & 4 A
ROUTE 29 (1953)
From Byram to Kingwood Station
PAVING
Scales as Indicated


PUBLIC UTILITIES	
N. J. POWER AND LIGHT CO. 400 LINCOLN ST.	PHILLIPSBURG, N.J.
N. J. BELL TELEPHONE CO. LOCAL OFFICE 9 OAKLAND AVE	NEWARK, N.J. TRENTON, N.J.
PENNSYLVANIA RAILROAD PENNSYLVANIA STATION	NEW YORK, N.Y.

STATE OF NEW JERSEY HIGHWAY DEPARTMENT

PLANS OF ROUTE 29 (1953) SECTION 1 From Raven Rock to Byram

GRADING and PAVING
Townships of Delaware and Kingwood Hunterdon County
Scales as Indicated May 1959

As Built - SEPT. 1960

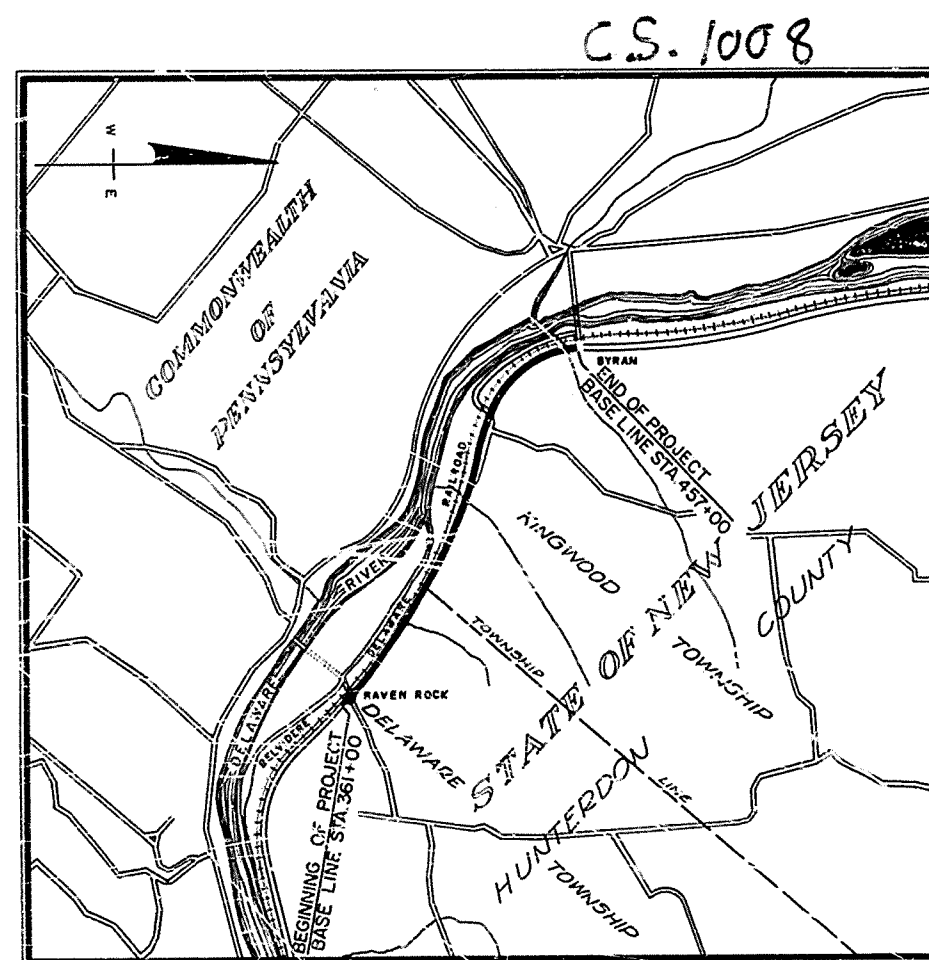

KEY MAP


SCALE 2" = 1 MILE

LENGTH OF PROJECT 9600.00 LIN. FT. 1.818 MILES
STANDARD HIGHWAY SPECIFICATIONS OF 1941 TO GOVERN

Submitted by H.W. Gifford 5-13-59
Director and Chief Engineer Date
Division of Roads, Design and Construction
Approved by C.H. Fritzsche 5-14-59
State Highway Engineer Date
Approved by _____
State Highway Commissioner Date

TYPICAL SECTIONS

Scale: 1" = 3' 0"

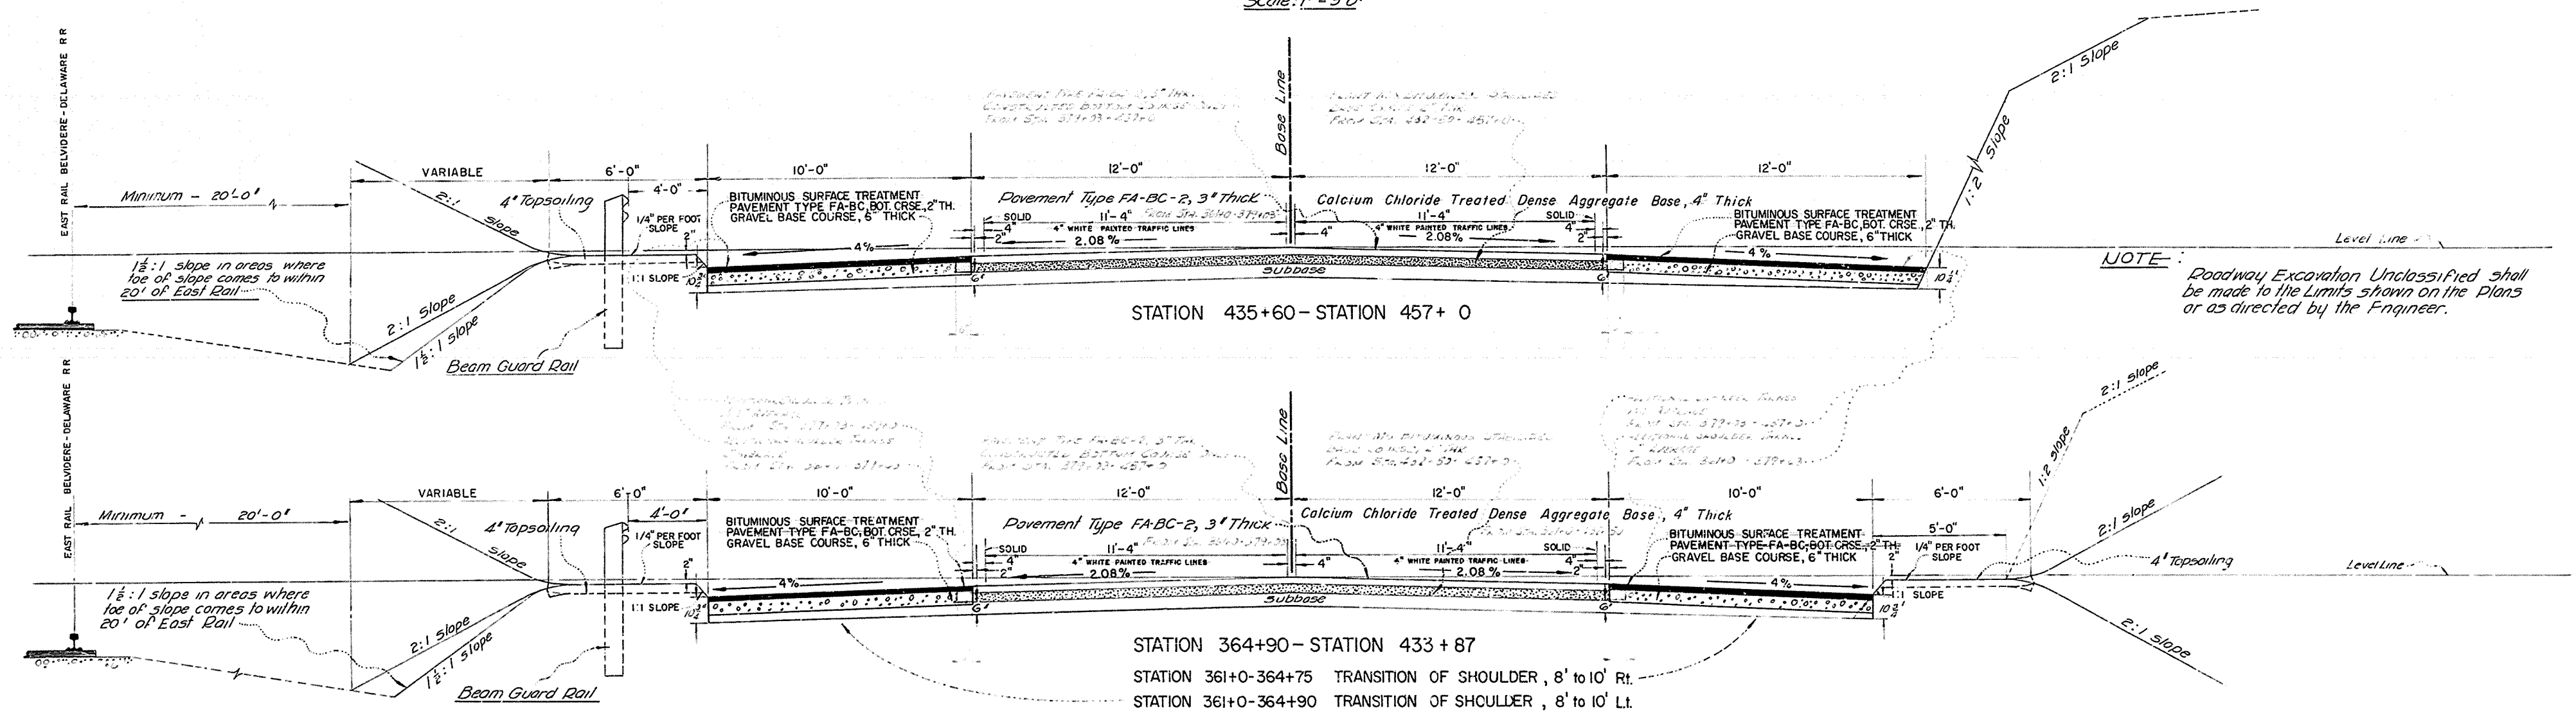

ESTIMATE OF QUANTITIES

ITEM NO.	DESCRIPTION	UNIT	CONTRACT QUANTITY	AS-BUILT QUANTITY	ITEM NO.	DESCRIPTION	UNIT	CONTRACT QUANTITY	AS-BUILT QUANTITY
1	FIELD OFFICE	LUMP SUM	LUMP SUM	2,000.00	28	9'-6" x 6'-5" STRUCTURAL PLATE PIPE ARCH	LIN. FT.	76	76
2	CLEARING SITE	LUMP SUM	LUMP SUM	1,000.00	29	INLETS, TYPE B	UNIT	12	12
3	STRIPPING	ACRE	2	2	30	INLETS, TYPE E	UNIT	4	4
4	ROADWAY EXCAVATION, UNCLASSIFIED	CU. YD.	58,946	58,946	31	INLET BOXES	UNIT	1	1
5	WET EXCAVATION	CU. YD.	4500	4500	32	RESET INLET HEADS	UNIT	8	8
6	CHANNEL EXCAVATION, UNCLASSIFIED	CU. YD.	300	300	33	GROUTED RUBBLE STONE GUTTER	SQ. YD.	20	20
7	DITCH EXCAVATION	CU. YD.	600	600	34	HEADWALLS, APRONS AND PIPE PLUGS	CU. YD.	95	95
8	EARTH EXCAVATION FOR TEST PITS	CU. YD.	10	10	35	STANDARD BEAM GUARD RAIL	LIN. FT.	6,677	6,677
9	ROCK EXCAVATION, SUBSURFACE STRUCTURES	CU. YD.	700	700	36	4" ASBESTOS CEMENT CONDUIT	LIN. FT.	180	180
10	EARTH EXCAVATION SUBSURFACE STRUCTURES, ADDITIONAL DEPTH	CU. YD.	25	25	37	1" GALVANIZED WATER PIPE	LIN. FT.	180	180
11	BORROW EXCAVATION, ZONE 2	CU. YD.	4,500	4,500	38	MONUMENTS	UNIT	20	20
12	BORROW EXCAVATION, ZONE 3	CU. YD.	5,000	5,000	39	FERTILIZING AND SEEDING	SQ. YD.	14,000	14,000
13	4" TOPSOILING	SQ. YD.	11,000	11,000	40	MULCHING (HAY)	SQ. YD.	25,000	25,000
14	CONCRETE BAG SLOPE PROTECTION	CU. YD.	15	15	41	UNDERDRAIN, TYPE F	LIN. FT.	1,000	1,000
15	CALCIUM CHLORIDE TREATED DENSE AGGREGATE BASE, 4" THICK	SQ. YD.	27,450	27,450	42	CALCIUM CHLORIDE	TON	28	28
16	PAVEMENT TYPE FA-BC-2, 3" THICK	SQ. YD.	27,450	27,450	43	SUBBASE	CU. YD.	6,800	6,800
17	BROKEN STONE OR WASHED GRAVEL	CU. YD.	60	60	44	GRAVEL BASE COURSE, 6" THICK	SQ. YD.	21,227	21,227
18	PRIME COAT	GALLON	12,120	12,120	45	PAVEMENT TYPE FA-BC, BOTTOM COURSE, 2" THICK	SQ. YD.	21,006	21,006
19	12" REINFORCED CONCRETE CULVERT PIPE	LIN. FT.	50	50	46	SURFACE TREATMENT BITUMINOUS MATERIAL	GAL.	8,404	8,404
20	18" REINFORCED CONCRETE CULVERT PIPE	LIN. FT.	112	112	47	SURFACE TREATMENT COVER MATERIAL	TON	292	292
21	24" REINFORCED CONCRETE CULVERT PIPE	LIN. FT.	290	290	48	9" x 20" WHITE CONCRETE VERTICAL CURB	LIN. FT.	200	200
22	18" CAST IRON CULVERT PIPE, EXTRA HEAVY	LIN. FT.	314	314	49	4" WHITE PAINTED TRAFFIC LINES	LIN. FT.	25,000	25,000
23	30" CAST IRON CULVERT PIPE, EXTRA HEAVY	LIN. FT.	74	74	50	INLET HEAD, TYPE E	UNIT	1	1
24	6" CORRUGATED METAL PIPE	LIN. FT.	84	84					
25	18" CORRUGATED METAL CULVERT PIPE	LIN. FT.	240	240					
26	6'-1" x 4'-7" STRUCTURAL PLATE PIPE ARCH	LIN. FT.	96	96					
27	7'-0" x 5'-1" STRUCTURAL PLATE PIPE ARCH	LIN. FT.	92	92					

New Jersey
State Highway Department
ESTIMATE OF QUANTITIES
TYPICAL SECTIONS
ROUTE 29 (1953) SECTION 1
From Raven Rock to Byram
GRADING and PAVING
Scale as Indicated

1008 002 039




APPENDIX III

Cost Analysis

RT. 29 ROCKFALL CONCEPT DEVELOPMENT CONSTRUCTION COST ESTIMATE SUMMARY

Area	Option	Description	ESTIMATE COST	LOWER BOUND	UPPER BOUND
A	I	No Action	\$ -	\$ -	\$ -
	II	Removal – Regrade with Catchment Ditch	\$ 299,000	\$ 150,000	\$ 449,000
	III	Removal – Remove Vegetation and Scale	\$ 371,000	\$ 186,000	\$ 557,000
	IV	Removal / Protection - Remove Vegetation, Scale, and Install Draped Mesh	\$ 1,040,000	\$ 520,000	\$ 1,560,000
	V	Removal / Protection – Reslope and Construct Catchment Ditch, Install Draped Mesh on Upper Portion of Lower Slope	\$ 841,000	\$ 421,000	\$ 1,262,000
	VI	Reinforcement – Install Grouted Dowels and Shotcrete Facing	\$ 1,693,000	\$ 847,000	\$ 2,540,000
	VII	Reinforcement – Install Anchored Mesh, Spot Dowels / Rock Bolts	\$ 1,664,000	\$ 832,000	\$ 2,496,000
B	I	No Action	\$ -	\$ -	\$ -
	II	Protection – Reslope, Construct Catchment Ditch, and Fence at Crest of Lower Slope	\$ 1,366,000	\$ 683,000	\$ 2,049,000
	III	Protection – Hybrid System - Barrier at Crest of Lower Slope and Draped Mesh on Lower Face	\$ 2,240,000	\$ 1,120,000	\$ 3,360,000
	IV	Protection – Improved Catchment with Hybrid System (Combination of Options II and III)	\$ 2,640,000	\$ 1,320,000	\$ 3,960,000
C	I	No Action	\$ -	\$ -	\$ -
	II	Protection – Reslope, Construct Catchment Ditch, and Fence at Crest of Lower Slope	\$ 9,334,000	\$ 4,667,000	\$14,001,000
	III	Protection – Hybrid System - Barrier at Crest of Lower Slope and Draped Mesh on Lower Face	\$11,013,000	\$ 5,507,000	\$16,520,000
	IV	Protection – Improved Catchment with Hybrid System (Combination of Options II and III)	\$14,603,000	\$ 7,302,000	\$21,905,000
D	I	No Action	\$ -	\$ -	\$ -
	II	Warning – Install Rockfall Warning Fence	\$ 2,745,000	\$ 1,373,000	\$ 4,118,000
	III	Monitoring – Inclinator, Tiltmeters, and/or Routinely Scheduled LiDar Survey	\$ 2,579,000	\$ 1,290,000	\$ 3,869,000
	IV	Removal – Trim blasting and Rock Removal Using Airbags and Scaling	\$ 6,261,000	\$ 3,131,000	\$ 9,392,000
	V	Reinforcement – Install Tensioned Rock Bolts, Dental Concrete, and Anchored Mesh	\$ 9,025,000	\$ 4,513,000	\$13,538,000
	VI	Protection – Install Hybrid System Barrier at Crest of Lower Slope and Draped Mesh below, or Draped Mesh with Sacrificial Fences	\$10,086,000	\$ 5,043,000	\$15,129,000
	VII	Protection – Raise Roadway Elevation or shift Roadway West to Create Catchment	\$10,792,000	\$ 5,396,000	\$16,188,000
	VIII	Protection – Rock Shed over Road	\$17,128,000	\$ 8,564,000	\$25,692,000
	IX	Combination - Localized Trim Blasting, Reinforcement of Devil's tea Table and Shotcrete or Dental Concrete	\$12,356,000	\$ 6,178,000	\$18,534,000

Green cells indicate preliminary preferred alternative.

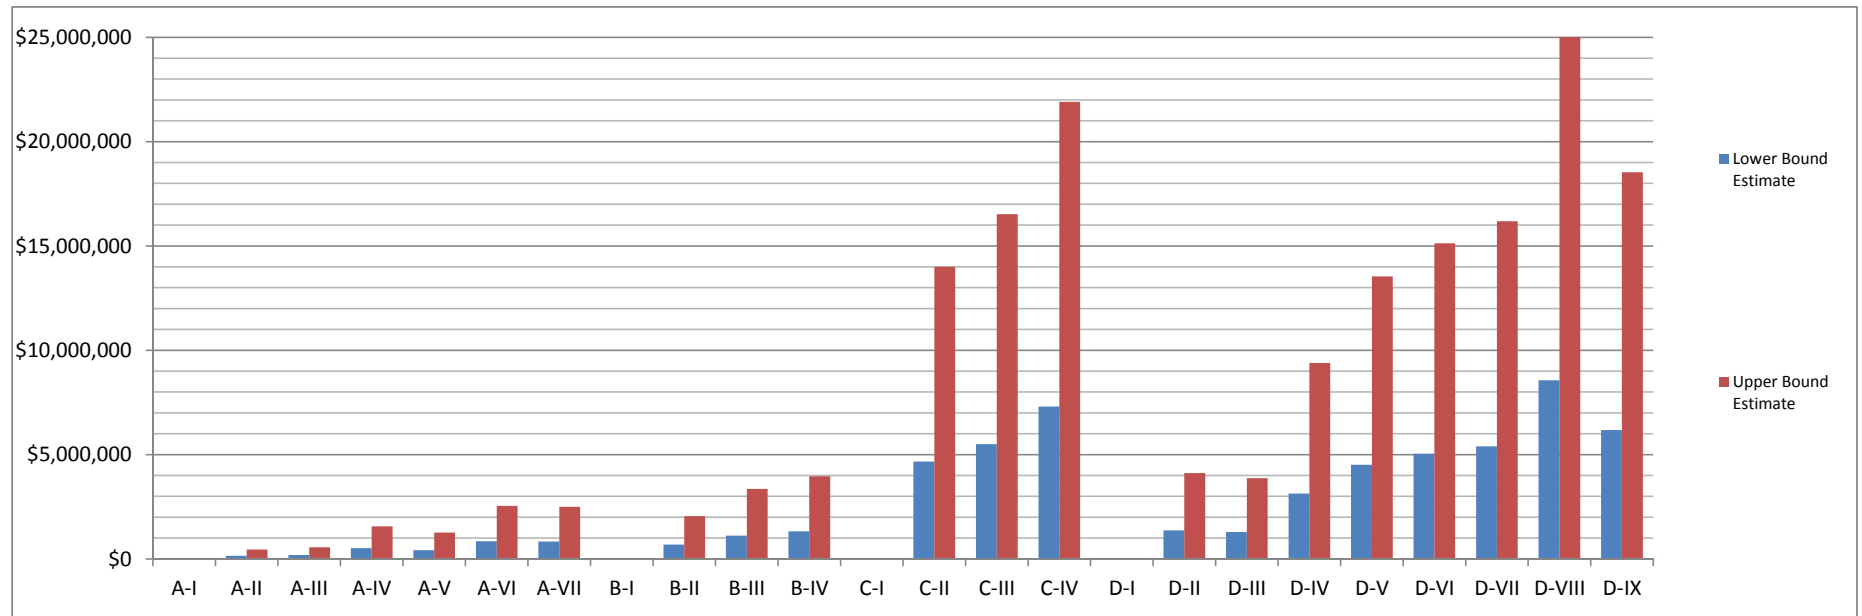

For:	Rt. 29 Rockfall	Job Number:	59447	Sheet No.	
By:	BTF	Check By:	NN & JS	Check by:	PDT
Date:	1/19/2015	Date:	1/20/2014	Date:	2/20/2015



CONCEPT DEVELOPMENT QUANTITY AND COST ESTIMATE

Area	Option	Description	Lower Slope				Upper Slope				Total Slope Face Area (sf)	Cut Area (ft²/ft) (See Attached)	Item	QUANTITY	UNIT	UNIT COST	ESTIMATE COST	ESTIMATE COST	LOWER BOUND	UPPER BOUND	
			Slope Length (ft)	Slope Height (ft)	Slope Angle (degrees)	Slope Face Area (sf)	Slope Length (ft)	Slope Height (ft)	Slope Angle (degrees)	Slope Face Area (sf)											
A	I	No Action	500	75	60	43,301				-	43,301	-	-	-	0	-	\$0.00	\$0	\$0	\$0	\$0
	II	Removal – Regrade with Catchment Ditch	500	75	60	43,301				-	43,301	152	Rock Excavation	Cut Area x L / 27	2,823	CY	\$90.00	\$254,048	\$298,927	\$149,463	\$448,390
													Embankment	8'H x2'V x 0.5' x L / 27	148	CY	\$40.00	\$5,926			
													Asphalt	2.16 tn/cy x L x 44' x 0.167' / 27 cf/cy	294	Tons	\$90.00	\$26,453			
													Rock Drain Holes	L / 50 spacing * 50' long	500	ft	\$25.00	\$12,500			
	III	Removal – Remove Vegetation and Scale	500	75	60	43,301				-	43,301	-	Vegetation Removal	Slope Face Area / 9	4,811	SY	\$3.00	\$14,434	\$370,929	\$185,465	\$556,394
													Rock Scaling	Slope Face Area / 27	529	CY	\$600.00	\$317,543			
													Asphalt	2.16 tn/cy x L x 44' x 0.167' / 27 cf/cy	294	Tons	\$90.00	\$26,453			
													Rock Drain Holes	L / 50 spacing * 50' long	500	ft	\$25.00	\$12,500			
	IV	Removal / Protection - Remove Vegetation, Scale, and Install Draped Mesh	500	75	60	43,301				-	43,301	-	Vegetation Removal	Slope Face Area / 9	4,811	SY	\$3.00	\$14,434	\$1,039,647	\$519,823	\$1,559,470
													Rock Scaling	Slope Face Area / 27	529	CY	\$600.00	\$317,543			
													Rock Dowels	Dowel Length x (L / Draped Mesh Anchor Spacing)	625	LF	\$100.00	\$62,500			
													Draped Mesh	Slope Face Area	43,301	SF	\$14.00	\$606,218			
													Asphalt	2.16 tn/cy x L x 44' x 0.167' / 27 cf/cy	294	Tons	\$90.00	\$26,453			
													Rock Drain Holes	L / 50 spacing * 50' long	500	ft	\$25.00	\$12,500			
	V	Removal / Protection – Reslope and Construct Ditch, Install Draped Mesh on Upper Slope	500	75	60	43,301				-	43,301	152	Rock Excavation	Cut Area x L / 27 x 0.5	1,411	CY	\$90.00	\$127,024	\$840,620	\$420,310	\$1,260,931
													Embankment	8'H x2'V x 0.5' x L / 27	148	CY	\$40.00	\$5,926			
													Rock Dowels	Dowel Length x (L / Draped Mesh Anchor Spacing)	625	LF	\$100.00	\$62,500			
													Draped Mesh	Slope Face Area	43,301	SF	\$14.00	\$606,218			
													Asphalt	2.16 tn/cy x L x 44' x 0.167' / 27 cf/cy	294	Tons	\$90.00	\$26,453			
													Rock Drain Holes	L / 50 spacing * 50' long	500	ft	\$25.00	\$12,500			
	VI	Reinforcement – Install Grouted Dowels and Shotcrete Facing	500	75	60	43,301				-	43,301	-	Vegetation Removal	Slope Face Area / 9	4,811	SY	\$3.00	\$14,434	\$1,692,617	\$846,309	\$2,538,926
													Rock Scaling	Slope Face Area * Thickness / 27	529	CY	\$600.00	\$317,543			
													Rock Dowels	[(H' / Anchor Spacing) x (L' / Anchor Spacing)] Dowel L	6,000	LF	\$100.00	\$600,000			
													Shotcrete	Slope Face Area / 9	4,811	SY	\$150.00	\$721,688			
													Asphalt	2.16 tn/cy x L x 44' x 0.167' / 27 cf/cy	294	Tons	\$90.00	\$26,453			
													Rock Drain Holes	L / 50 spacing * 50' long	500	ft	\$25.00	\$12,500			
	VII	Reinforcement – Install Anchored Mesh, Spot Dowel / Rock Bolts	500	75	60	43,301				-	43,301	-	Vegetation Removal	Slope Face Area / 9	4,811	SY	\$3.00	\$14,434	\$1,663,750	\$831,875	\$2,495,624
Rock Scaling													Slope Face Area * Thickness / 27	529	CY	\$600.00	\$317,543				
Rock Dowels													[(H' / Anchor Spacing) x (L' / Anchor Spacing)] Dowel L	6,000	LF	\$100.00	\$600,000				
Anchored Mesh													Slope Face Area	43,301	SF	\$16.00	\$692,820				
Asphalt													2.16 tn/cy x L x 44' x 0.167' / 27 cf/cy	294	Tons	\$90.00	\$26,453				
Rock Drain Holes													L / 50 spacing * 50' long	500	ft	\$25.00	\$12,500				
B	I	No Action	580	35	35	35,392	580	35	85	20,378	55,770	-	-	-	0	-	\$0.00	\$0	\$0	\$0	\$0
	II	Protection – Reslope, Construct Catchment Dithc, and Fence at Crest of Lower Slope	580	35	35	35,392	580	35	85	20,378	55,770	170	Rock Excavation	Cut Area x L / 27	3,645	CY	\$90.00	\$328,012	\$1,366,071	\$683,035	\$2,049,106
													Embankment	8'H x2'V x 0.5' x L / 27	172	CY	\$40.00	\$6,874			
													Rockfall Barrier	Slope Length	580	LF	\$1,700.00	\$986,000			
													Asphalt	2.16 tn/cy x L x 44' x 0.167' / 27 cf/cy	341	Tons	\$90.00	\$30,685			
													Rock Drain Holes	L / 50 spacing * 50' long	580	ft	\$25.00	\$14,500			
	III	Protection – Hybrid System - Barrier at Crest of Lower Slope and Draped Mesh on Lower Face	580	35	35	35,392	580	35	85	20,378	55,770	-	Vegetation Removal	Slope Face Area / 9	6,197	SY	\$3.00	\$18,590	\$2,239,525	\$1,119,762	\$3,359,287
													Rock Scaling	Slope Face Area * Thickness / 27	682	CY	\$600.00	\$408,976			
													Rockfall Barrier	Slope Length	580	LF	\$1,700.00	\$986,000			
													Draped Mesh	Slope Face Area	55,770	SF	\$14.00	\$780,773			
													Asphalt	2.16 tn/cy x L x 44' x 0.167' / 27 cf/cy	341	Tons	\$90.00	\$30,685			
	Rock Drain Holes	L / 50 spacing * 50' long	580	ft	\$25.00	\$14,500															
	IV	Protection – Improved Catchment with Hybrid System (Combination of Options II and III)	580	35	35	35,392	580	35	85	20,378	55,770	-	Vegetation Removal	Slope Face Area / 9	6,197	SY	\$3.00	\$18,590	\$2,640,036	\$1,320,018	\$3,960,054
													Rock Excavation	Cut Area x L / 27	3,645	CY	\$90.00	\$328,012			
													Rock Scaling	Slope Face Area	682	CY	\$600.00	\$408,976			
													Rock Dowels	Dowel Length x (L / Draped Mesh Anchor Spacing)	725	LF	\$100.00	\$72,500			
Rockfall Barrier													Slope Length	580	LF	\$1,700.00	\$986,000				
Draped Mesh													Slope Face Area	55,770	SF	\$14.00	\$780,773				
Asphalt													2.16 tn/cy x L x 44' x 0.167' / 27 cf/cy	341	Tons	\$90.00	\$30,685				
Rock Drain Holes													L / 50 spacing * 50' long	580	ft	\$25.00	\$14,500				
C	I	No Action	3,450	50	50	225,183						-	-	-	0	-	\$0.00	\$0	\$0	\$0	\$0
	II	Protection – Reslope, Construct Catchment Dithc, and Fence at Crest of Lower Slope	3,450	50	50	225,183						275	Rock Excavation	Cut Area x L / 27	35,098	CY	\$90.00	\$3,158,850	\$9,333,513	\$4,666,757	\$14,000,270
													Embankment	8'H x2'V x 0.5' x L / 27	1,022	CY	\$40.00	\$40,889			
													Rockfall Barrier	Slope Length	3,450	LF	\$1,700.00	\$5,865,000			
													Asphalt	2.16 tn/cy x L x 44' x 0.167' / 27 cf/cy	2,028	Tons	\$90.00	\$182,524			
													Rock Drain Holes	L / 50 spacing * 50' long	3,450	ft	\$25.00	\$86,250			
	III	Protection – Hybrid System - Barrier at Crest of Lower Slope and Draped Mesh on Lower Face	3,450	50	50	225,183						-	Vegetation Removal	Slope Face Area / 9	25,020	SY	\$3.00	\$75,061	\$11,012,734	\$5,506,367	\$16,519,101
													Rock Scaling	Slope Face Area * Thickness / 27	2,752	CY	\$600.00	\$1,651,340			
													Rockfall Barrier	Slope Length	3,450	LF	\$1,700.00	\$5,865,000			
													Draped Mesh	Slope Face Area	225,183	SF	\$14.00	\$3,152,559			
													Asphalt	2.16 tn/cy x L x 44' x 0.167' / 27 cf/cy	2,028	Tons	\$90.00	\$182,524			
	Rock Drain Holes	L / 50 spacing * 50' long	3,450	ft	\$25.00	\$86,250															
	IV	Protection – Improved Catchment with Hybrid System (Combination of Options II and III)	3,450	50	50	225,183						-	Vegetation Removal	Slope Face Area / 9	25,020	SY	\$3.00	\$75,061	\$14,602,834	\$7,301,417	\$21,904,251
													Rock Excavation	Cut Area x L / 27	35,098	CY	\$90.00	\$3,158,850			
													Rock Scaling	Slope Face Area * Thickness / 27	2,752	CY	\$600.00	\$1,651,340			
													Rock Dowels	Dowel Length x (L / Draped Mesh Anchor Spacing)	4,313	LF	\$100.00	\$431,250			
Rockfall Barrier													Slope Length	3,450	LF	\$1,700.00	\$5,865,000				
Draped Mesh													Slope Face Area	225,183	SF	\$14.00	\$3,152,559				
Asphalt													2.16 tn/cy x L x 44' x 0.167' / 27 cf/cy	2,028	Tons	\$90.00	\$182,524				
Rock Drain Holes													L / 50 spacing * 50' long	3,450	ft	\$25.00	\$86,250				

For:	Rt. 29 Rockfall	Job Number:	59447	Sheet No.	
By:	BTF	Check By:	NN & JS	Check by:	PDT
Date:	1/19/2015	Date:	1/20/2014	Date:	2/20/2015



CONCEPT DEVELOPMENT QUANTITY AND COST ESTIMATE

Area	Option	Description	Lower Slope				Upper Slope				Total Slope Face Area (sf)	Cut Area (ft²/ft) (See Attached)	Item	QUANTITY	UNIT	UNIT COST	ESTIMATE COST	ESTIMATE COST	LOWER BOUND	UPPER BOUND	
			Slope Length (ft)	Slope Height (ft)	Slope Angle (degrees)	Slope Face Area (sf)	Slope Length (ft)	Slope Height (ft)	Slope Angle (degrees)	Slope Face Area (sf)											
D	I	No Action	3,000	200	65	662,027				-	662,027	-	-	-	0	-	\$0.00	\$0	\$0	\$0	
	II	Warning – Install Rockfall Warning Fence	3,000	200	65	662,027					662,027	-	Vegetation Removal	0.1 * Slope Face Area	66,203	SY	\$3.00	\$198,608	\$2,744,581	\$1,372,290	\$4,116,871
													Rock Scaling	0.2 * Slope Face Area	1,618	CY	\$600.00	\$970,973			
													Warning Fence	Slope Length	3,000	LF	\$500.00	\$1,500,000			
													Rock Drain Holes	L / 50 spacing * 50' long	3,000	ft	\$25.00	\$75,000			
	III	Monitoring – Inclinometer, Tiltmeters, and/or Routinely Scheduled LiDar Survey	3,000	200	65	662,027					662,027	-	Vegetation Removal	0.1 * Slope Face Area	66,203	SY	\$3.00	\$198,608	\$2,578,581	\$1,289,290	\$3,867,871
													Rock Scaling	0.2 * Slope Face Area	1,618	CY	\$600.00	\$970,973			
													Inclinometer	Inclinometers	4	EA	\$20,000.00	\$80,000			
													Tiltmeter	(No of Tiltmeters / Area) / Slope Face Area	4	EA	\$1,000.00	\$4,000			
													LiDar Survey	No of LiDar Surveys (Once per year for 25 years)	25	EA	\$50,000.00	\$1,250,000			
													Rock Drain Holes	L / 50 spacing * 50' long	3,000	ft	\$25.00	\$75,000			
	IV	Removal – Trim blasting and Rock removal Using Airbags and Scaling	3,000	200	65	662,027					662,027	97	Vegetation Removal	Slope Face Area x 0.1	66,203	SY	\$3.00	\$198,608	\$6,260,781	\$3,130,391	\$9,391,172
													Rock Scaling	Slope Face Area	8,091	CY	\$600.00	\$4,854,863			
													Rock Excavation	Cut Area x L /27	10,818	CY	\$90.00	\$973,594			
													Asphalt	2.16 tn/cy x L x 44' x 0.167' / 27 cf/cy	1,764	Tons	\$90.00	\$158,717			
													Rock Drain Holes	L / 50 spacing * 50' long	3,000	ft	\$25.00	\$75,000			
	V	Reinforcement – Install Tensioned Rock Bolts, Dental Concrete, and Anchored Mesh	3,000	200	65	662,027					662,027	-	Vegetation Removal	Slope Face Area x 0.1	66,203	SY	\$3.00	\$198,608	\$9,025,284	\$4,512,642	\$13,537,925
													Rock Scaling	Slope Face Area	8,091	CY	\$600.00	\$4,854,863			
													Rock Dowels	Dowel Length x (L / Draped Mesh Anchor Spacing)	3,750	LF	\$100.00	\$375,000			
													Rock Bolt Testing	Slope Face Area / (No. of Rock Bolts / Area)	66	EA	\$1,800.00	\$119,165			
													Shotcrete	0.15 * Slope Face Area / 9	11,034	SY	\$150.00	\$1,655,067			
													Anchored Mesh	0.15* Slope Face Area	99,304	SF	\$16.00	\$1,588,864			
													Asphalt	2.16 tn/cy x L x 44' x 0.167' / 27 cf/cy	1,764	Tons	\$90.00	\$158,717			
													Rock Drain Holes	L / 50 spacing * 50' long	3,000	ft	\$25.00	\$75,000			
	VI	Protection – Install Hybrid System Barrier at Crest of Lower Slope and Draped Mesh below, or Draped Mesh with Sacrificial Fences	3,000	200	65	662,027					662,027	-	Vegetation Removal	Slope Face Area x 0.1	66,203	SY	\$3.00	\$198,608	\$10,086,194	\$5,043,097	\$15,129,291
													Rock Scaling	Slope Face Area	8,091	CY	\$600.00	\$4,854,863			
													Rockfall Barrier	Slope Length x 0.65	1,950	LF	\$1,700.00	\$3,315,000			
													Rock Dowels	Dowel Length x (0.25xL / Draped Mesh Anchor Spacing)	938	LF	\$100.00	\$93,750			
													Draped Mesh	Slope Face Area x 0.15	99,304	SF	\$14.00	\$1,390,256			
													Asphalt	2.16 tn/cy x L x 44' x 0.167' / 27 cf/cy	1,764	Tons	\$90.00	\$158,717			
													Rock Drain Holes	L / 50 spacing * 50' long	3,000	ft	\$25.00	\$75,000			
	VII	Protection – Raise Roadway Elevation or shift Roadway West to Create Catchment	3,000	200	65	662,027					662,027	-	Vegetation Removal	Slope Face Area x 0.1	66,203	SY	\$3.00	\$198,608	\$10,791,671	\$5,395,835	\$16,187,506
													Rock Scaling	Slope Face Area	8,091	CY	\$600.00	\$4,854,863			
													Embankment	Area of Roadway x Thickness of Roadway	100,000	CY	\$40.00	\$4,000,000			
													Asphalt	2.16 tn/cy x L x 44' x 1.75' / 27 cf/cy (Full Depth)	18,480	Tons	\$90.00	\$1,663,200			
													Rock Drain Holes	L / 50 spacing * 50' long	3,000	ft	\$25.00	\$75,000			
	VIII	Protection – Rock Shed over Road	3,000	200	65	662,027					662,027	-	Vegetation Removal	Slope Face Area	66,203	SY	\$3.00	\$198,608	\$17,128,471	\$8,564,235	\$25,692,706
													Rock Scaling	Slope Face Area	8,091	CY	\$600.00	\$4,854,863			
													Rock Shed	No of Rocksheds	1	EA	\$12,000,000.00	\$12,000,000			
													Rock Drain Holes	L / 50 spacing * 50' long	3,000	ft	\$25.00	\$75,000			
	IX	Combination – Blasting to Create a Mid-Slope Bench, Reinforcement of Devil's Tea Table with Tensioned Rock Bolts and Shotcrete	3,000	200	65	662,027					662,027	500	Vegetation Removal	Slope Face Area x 0.1	66,203	SY	\$3.00	\$198,608	\$12,356,142	\$6,178,071	\$18,534,213
													Rock Excavation	Cut Area x L /27	55,556	CY	\$90.00	\$5,000,000			
													Rock Dowels	Dowel Length x (0.33 L / Draped Mesh Anchor Spacing)	1,238	LF	\$100.00	\$123,750			
													Rockfall Barrier	Length of Slope	3,000	LF	\$1,700.00	\$5,100,000			
													Rock Bolt Testing	Assumed 25	25	EA	\$1,800.00	\$45,000			
													Asphalt	2.16 tn/cy x L x 44' x 0.167' / 27 cf/cy	1,764	Tons	\$90.00	\$158,717			
													Shotcrete	0.15 * Slope Face Area / 9	11,034	SY	\$150.00	\$1,655,067			
													Rock Drain Holes	L / 50 spacing * 50' long	3,000	ft	\$25.00	\$75,000			

References:

- 1) Indicates input values, all other cells are equations or descriptive
- 2) The following assumptions were made throughout the quantity estimates above:

0.33

(ft) = Scaling Thickness

12

(ft) = Anchor Spacing (Draped Mesh)

10

(ft) = Anchor Spacing (Shotcrete or Anchored Mesh)

10

(ft) = Anchor Spacing (Barrier Mesh)

15

(ft) = Dowel Length
- 3) Unit costs based obtain from a Rockfall Specialty Contractor 1/7/15 and NJDOT Bid Price Reports.

Assumed Unit Costs:

	-	\$0.00	
Vegetation Removal	SY	\$3.00	
Embankment	CY	\$40.00	
Rock Scaling	CY	\$600.00	
Rock Excavation	CY	\$90.00	(Pre-Split Drilling Incidental)
Rock Dowels	LF	\$100.00	Tensioned rock bolts assumed to have the same unit cost
Anchored Mesh	SF	\$16.00	
Draped Mesh	SF	\$14.00	
Shotcrete	SY	\$150.00	Assuming 4" Thick
Rockfall Barrier	LF	\$1,700.00	Includes Rock Anchor Costs
Rock Bolt Testing	EA	\$1,800.00	
Warning Fence	LF	\$500.00	
Inclinometer	EA	\$20,000.00	
Tiltmeter	EA	\$1,000.00	
LiDar Survey	EA	\$50,000.00	
Rock Shed	EA	\$12,000,000.00	
Asphalt	Tons	\$90.00	
Rock Drain Holes	ft	\$25.00	Assume 50 ft Long Every 50'

APPENDIX IV

2003 Rockfall Hazard Ratings and Report

RHRS FIELD DATA SHEET

Area A

HIGHWAY:

REGION:

HIGHWAY # <u>Route 29</u>	Beginning M.P. <u>27.40</u>	L / <u>(R)</u>	Ending M.P. <u>27.50</u>
COUNTY # <u>Hunterdon</u>	DATE <u>8-26-03</u>	NEW	Rated By <u>P. Ulikashi</u>
CLASS <u>(A)</u> B	ADT <u>2400</u>	UPDATE	Speed Limit <u>50 MPH</u>

CATEGORY	REMARKS	CATEGORY SCORE
Slope Height <u>75</u> ft		SLOPE HEIGHT <u>27</u>
Ditch Effectiveness G M L <u>(N)</u>		DITCH EFFECT <u>95</u>
Average Vehicle Risk <u>20</u> %		AVR <u>25</u>
Sight Distance <u>525</u> ft		SIGHT DISTANCE <u>6</u>
Percent Decision Site Distance <u>70</u> %		
Roadway Width <u>40</u> ft		ROADWAY WIDTH <u>5</u>
GEOLOGIC CHARACTER		GEOLOGIC CHARACTER
CASE 1		CASE 1
Structural Condition D <u>(F)</u> R <u>(A)</u>		STRUCT COND <u>95</u>
Rock Friction R I U <u>(P)</u> C - S		ROCK FRICTION <u>45</u>
CASE 2		CASE 2
Differential Erosion Features F O <u>(N)</u> M		DIF ER FEATURES <u>30</u>
Difference in Erosion Rates S <u>(M)</u> L E		DIF ER RATES <u>10</u>
Block Size/Volume <u>319</u> ft/yd ³		BLOCK SIZE <u>40</u>
Climate		
Precipitation L <u>(H)</u>		CLIMATE <u>22</u>
Freezing Period N <u>(S)</u> L		
Water on Slope N <u>(I)</u> C		
Rockfall History F O <u>(M)</u> C		ROCKFALL HISTORY <u>50</u>
COMMENTS: <u>Gray siltstone interbedded w/ dark gray diabase. Rock mass lightly fractured, forming many blocks. Slope face in general dry. Few talus scree indicating frost wedging action. Few small rock pieces on roadway indicating recent rock falls. Few blocks leaning against trees.</u>		TOTAL SCORE <u>310</u>

RHRS FIELD DATA SHEET

Area B

HIGHWAY:

REGION:

HIGHWAY # <u>Route 29</u>	Beginning M.P. <u>27.50</u>	L / <u>(R)</u>	Ending M.P. <u>27.65</u>
COUNTY # <u>Hunterdon</u>	DATE <u>8-21-03</u>	NEW	Rated By <u>P. Ullikashi</u>
CLASS <u>(A)</u> B	ADT <u>2400</u>	UPDATE	Speed Limit <u>50 MPH</u>

CATEGORY	REMARKS	CATEGORY SCORE
Slope Height <u>50</u> ft		SLOPE HEIGHT <u>9</u>
Ditch Effectiveness G M <u>(L)</u> N		DITCH EFFECT <u>60</u>
Average Vehicle Risk <u>30</u> %		AVR <u>4</u>
Sight Distance <u>600</u> ft		SIGHT DISTANCE <u>8</u>
Percent Decision Site Distance <u>83</u> %		
Roadway Width <u>40</u> ft		ROADWAY WIDTH <u>5</u>
GEOLOGIC CHARACTER		GEOLOGIC CHARACTER
CASE 1		CASE 1
Structural Condition D <u>(C)</u> F R <u>(A)</u>		STRUCT COND <u>85</u>
Rock Friction R I U <u>(D)</u> C - S		ROCK FRICTION <u>30</u>
CASE 2		CASE 2
Differential Erosion Features F O N <u>(H)</u>		DIF ER FEATURES <u>85</u>
Difference in Erosion Rates S <u>(H)</u> L E		DIF ER RATES <u>15</u>
Block Size/Volume <u>3</u> / <u>9</u> ft/yd ³		BLOCK SIZE <u>40</u>
Climate		
Precipitation L <u>(H)</u> H		CLIMATE <u>22</u>
Freezing Period M <u>(S)</u> L		
Water on Slope M <u>(D)</u> C		
Rockfall History F O <u>(H)</u> C		ROCKFALL HISTORY <u>68</u>
COMMENTS: <u>Dark gray siltstone w/ massive parallel bedding. Random continuous fractures. Evidence of recent rock falls w/ blocks > 1 yd³ in size. Damaged vegetation @ places. Many loose blocks on cut slope face sitting metastably. Talus screen indicating frost wedging action. Few blocks leaning against trees. Deer Track found @ one spot in southern end of slope.</u>		TOTAL SCORE <u>316</u>

RHRS FIELD DATA SHEET

Area C

HIGHWAY:

REGION:

HIGHWAY # <u>Route 29</u>	Beginning M.P. <u>27.78</u>	L ☒ R	Ending M.P. <u>28.48</u>
COUNTY # <u>Hunterdon</u>	DATE <u>8-21-03</u>	NEW	Rated By <u>P. Ulikas</u>
CLASS <u>(A)</u> B	ADT <u>2400</u>	UPDATE	Speed Limit <u>50</u> MPH

CATEGORY	REMARKS	CATEGORY SCORE
Slope Height <u>7100</u> ft		SLOPE HEIGHT <u>100</u>
Ditch Effectiveness G M L <u>(H)</u>		DITCH EFFECT <u>90</u>
Average Vehicle Risk <u>140</u> %		AVR <u>100</u>
Sight Distance <u>1500</u> ft		SIGHT DISTANCE <u>8</u>
Percent Decision Site Distance <u>80</u> %		
Roadway Width <u>40</u> ft		ROADWAY WIDTH <u>5</u>
GEOLOGIC CHARACTER		GEOLOGIC CHARACTER
CASE 1		CASE 1
Structural Condition D <u>(C)</u> F R <u>(A)</u>		STRUCT COND <u>100</u>
Rock Friction R I U <u>(D)</u> C - S		ROCK FRICTION <u>40</u>
CASE 2		CASE 2
Differential Erosion Features F O N <u>(H)</u>		DIF ER FEATURES <u>90</u>
Difference in Erosion Rates S M <u>(L)</u> E		DIF ER RATES <u>45</u>
Block Size/Volume <u>5/12</u> ft/yd ³		BLOCK SIZE <u>100</u>
Climate		
Precipitation L <u>(H)</u> H		CLIMATE <u>22</u>
Freezing Period N <u>(S)</u> L		
Water on Slope N <u>(I)</u> C		
Rockfall History F O <u>(H)</u> C		ROCKFALL HISTORY <u>68</u>
COMMENTS: Rock varies from fine grained dark - brown sandstone to dark-gray siltstone-slate. Massively bedded to thinly laminated, moderate to severe erosional features; many overhangs w/ many freefalls @ the base of slope. Slope face has many talus scars indicating frost wedging action.		TOTAL SCORE <u>628</u>

RHRS FIELD DATA SHEET

Area D

HIGHWAY:

REGION:

HIGHWAY # <u>Route 29</u>	Beginning M.P. <u>29.85</u>	L/R <u>(R)</u>	Ending M.P. <u>30.45</u>
COUNTY # <u>Hunterdon</u>	DATE <u>8-20-03</u>	NEW	Rated By <u>Pradnep Ullkaski</u>
CLASS <u>(A)</u> B	ADT <u>2400</u>	UPDATE	Speed Limit <u>50 MPH</u>

CATEGORY	REMARKS	CATEGORY SCORE
Slope Height <u>> 100</u> ft		SLOPE HEIGHT <u>100</u>
Ditch Effectiveness G M <u>(L)</u> N		DITCH EFFECT <u>50</u>
Average Vehicle Risk <u>120</u> %		AVR <u>100</u>
Sight Distance <u>500</u> ft		SIGHT DISTANCE <u>13</u>
Percent Decision Site Distance <u>67</u> %		
Roadway Width <u>36</u> ft		ROADWAY WIDTH <u>09</u>
GEOLOGIC CHARACTER		GEOLOGIC CHARACTER
CASE 1		CASE 1
Structural Condition <u>(D)</u> C/F R <u>(A)</u>		STRUCT COND <u>47</u>
Rock Friction R I U <u>(P)</u> C - S		ROCK FRICTION <u>37</u>
CASE 2		CASE 2
Differential Erosion Features F O N <u>(M)</u>		DIF ER FEATURES <u>80</u>
Difference in Erosion Rates S M <u>(L)</u> E		DIF ER RATES <u>34</u>
Block Size/Volume <u>3/9</u> ft/yd ³		BLOCK SIZE <u>28</u>
Climate		
Precipitation <u>(L)</u> M/H		CLIMATE <u>22</u>
Freezing Period <u>(M)</u> S/L		
Water on Slope <u>(M)</u> I/C		
Rockfall History F O <u>(M)</u> C		ROCKFALL HISTORY <u>34</u>
COMMENTS:		TOTAL SCORE <u>470</u>

Presence of recent rockfalls w/ blocks < 1 yd³ in size. At least 2 trees found to have damage scars; Impact indentation marks on the road @ one spot; slope has few talus scars indicating frost wedging action. Some spots of slope have undergone extensive weathering; At least 2 rock columns on back slope seen; Seepage on slope face cut slope has 5-6 launching pads.

Golder Associates Inc.

The Federal Trust Building
24 Commerce Street, Suite 430, 4th Floor
Newark, NJ 07102
Telephone (973) 621-0777
Fax (973) 621-7725
www.golder.com

June 18, 2004



Project No.: 033-6228
ELECTRONIC MAIL AND FEDEX

The RBA Group
One Evergreen Place
Morristown, New Jersey 07962

DRAFT

Attn: Mr. Andrew M. Muldowney, P.E.

**Re: REMEDIAL DESIGN ALTERNATIVES REPORT
NEW JERSEY DEPARTMENT OF TRANSPORTATION
ROUTE 29 ROCKFALL MITIGATION EVALUATION PROJECT
LAMBERTVILLE TO FRENCHTOWN, NEW JERSEY**

Ladies and Gentlemen:

Golder Associates Inc. (Golder) is pleased to submit this **Remedial Design Alternatives Report** to The RBA Group (RBA) for the New Jersey Department of Transportation (NJDOT) Route 29 Rockfall Mitigation Evaluation Project. Approval to undertake and complete this rockfall hazard evaluation project and prepare this report was authorized by RBA under two (2) separate Subconsultant Agreements, dated June 30, 2003 and February 11, 2004.

SCOPE OF SERVICES

Golder was retained to undertake and complete a rockfall hazard review and evaluation to document current conditions, incorporate new data not included within previous studies, develop updated rockfall hazard ratings and develop preliminary, conceptual-level rockfall hazard remedial alternatives for each evaluated slope within the assessment corridor.

For the referenced project, the assessment corridor is defined by Route 29 Mile Posts (MP) 16 thru 34.5, or from the Southside of Lambertville, Mercer County, New Jersey to Frenchtown, Hunterdon County, New Jersey. See Figure 1. See Appendix "A" for drawings including aerial photographs and environmental constraints along the assessment corridor.

In summary, Golder's scope-of-work for the referenced project involved providing the following professional geotechnical engineering services:

- 1) Review previously completed rockfall hazard ratings of slopes within the assessment corridor;
- 2) Investigate and review available, historical rockfall data;
- 3) Inspect and photograph each evaluated slope to document current conditions;
- 4) Establish updated rockfall hazard ratings for each evaluated slope;

- 5) Develop preliminary, conceptual-level rockfall hazard remedial alternatives;
- 6) Provide rockfall hazard mitigation recommendations; and
- 7) Prepare a rockfall hazard Remedial Design Alternatives Report.

Summaries of completed field investigations and the findings/conclusions related to Items 1 thru 4 above were presented previously within two (2) separate technical memoranda dated November 5, 2003 and April 2, 2004 (see Appendices "B" and "C"). Hence, this report only provides the findings and conclusions related to Items 5 thru 7 above.

PROJECT DESCRIPTION

The Route 29 Rockfall Hazard Mitigation Project involves the identification of existing rockfall hazard risks and establishment of remedial design alternatives to mitigate said risks for rock cut slopes within the assessment corridor (along Route 29 from MP 16 to 34.5). See Figure 1. See Appendix "A".

In general, Route 29 runs parallel to the Delaware River from Trenton, Mercer County, New Jersey to Frenchtown, Hunterdon County, New Jersey. During construction of Route 29, numerous rock cuts were excavated into bedrock to make room for the roadway, and over time these slopes have shed rock debris due to a combination of ice/root jacking and/or geologic erosion mechanics.

The bedrock geology within the assessment corridor is characteristic of the Piedmont physiographic province, which include shales interbedded with sandstone, siltstone and argillites of the Brunswick formation; argillites interbedded with shale of the Lockatong formation; and sandstones interbedded with shale of the Stockton formation. Within the Piedmont province, steep slopes form bluffs along the Delaware River and follow along its tributary streams.

OVERVIEW OF ROCKFALL HAZARD RATINGS

During 1988 and 1989, NJDOT completed a system-wide review of all rock cut slopes along both State and Interstate Highway Systems in New Jersey, and this statewide review program can be summarized as follows:

- Phase I involved reviewing over 450 rock cut slopes, making cursory visual observations of each slope, assigning preliminary ratings and noting appropriate rockfall mitigation measures;
- Phase I identified over 110 rock cut slopes rated in the "High-High" (e.g., high probability of rockfall and high probability of rockfall reaching the travel lanes) category, and one (1) slope was identified as requiring immediate attention; and
- Phase II involved completing detailed hazard ratings on the identified "High-High" rock cut slopes.

In 1994, NJDOT updated its previously established 1988/1989 preliminary and detailed rockfall hazard ratings for the rock cut slopes identified along the referenced project's assessment corridor. See Table 1 for a summary of NJDOT's updated rockfall hazard slope ratings

Table 1 – 1994 Rockfall Hazard Slope Ratings

Start MP	End MP	Roadway Direction	1994 Slope Ratings
16.00		North	HH
17.30	17.80	North	Varies (LL to HH)
17.90		North	HH
18.05		North	HH
18.20		North	LL
18.60		North	HH
21.90		North	LH
23.10		North	HM
23.10		South	MM
23.20		North	HH
23.30		North	HH
26.00		North	HH
27.20		North	HH
27.30		North	HH
27.50		North	HH
27.78	28.38	North	HH
28.50		North	HH
29.10		North	MH
29.63	29.83	North	HH
29.85	30.45	North	HH

Notes:

- 1) "H" = High; "M" = Medium; "L" = Low
- 2) "XY" = "X" Potential for a Rockfall
"Y" Potential for a Fall to Reach Roadway

During August 2003 and March 2004, Golder re-inspected and re-evaluated all twenty (20) of the rock cut-slopes identified in Table 1 to collect new, additional, current slope data and to establish updated rockfall hazard ratings. In addition, Golder inspected and documented back-slope conditions above each evaluated rock cut-slope.

See Appendices "B" and "C" for technical memoranda dated November 5, 2003 and April 2, 2004, respectively, for additional information related to Golder's field investigation findings/conclusions and updated rockfall hazard slope ratings.

See Table 2 for a summary of Golder's updated rockfall hazard slope ratings for each of the evaluated rock cut slopes within the referenced project's assessment corridor.

Table 2 – 2004 Rockfall Hazard Slope Ratings

Start MP	End MP	Roadway Direction	Length (feet)	Height (feet)	Back Slope Angle	2004 Slope Ratings
16.00	16.01	North	75	25	60 degrees	B
17.30	17.90	North	4025	5 to 25	Varies	A
17.90	18.05					
18.05	18.06					
18.10	18.20	North	530	15	n/a	B

Start MP	End MP	Roadway Direction	Length (feet)	Height (feet)	Back Slope Angle	2004 Slope Ratings
18.60	18.63	North	160	15	n/a	B
21.90	21.97	North	350	40	n/a	B
23.10	23.12	North	80	25	n/a	C
23.10	23.16	South	300	40	n/a	C
23.20	23.23	North	160	30	n/a	C
23.30	23.36	North	330	5 to 25	n/a	C
26.00	26.10	North	530	60	40 degrees	B
27.20	27.30	North	740	20	n/a	B
27.30	27.34					
27.40	27.50	North	530	75	n/a	A
27.50	27.65	North	800	50	45 degrees	A
27.78	28.48	North	3700	>100	35 degrees	A
29.20	29.30	North	530	40	n/a	B
29.63	29.83	North	1060	30	n/a	B
29.85	30.45	North	3200	>100	40 degrees	A
Notes:						
1) All lengths, heights and angles presented are approximate, based on field measurements and/or estimations.						
2) See Table 3 for detailed rockfall hazard slope rating descriptions.						

Table 3 – Slope Rating Descriptions

Slope Rating	Description
A	<u>High Risk</u> : High potential for rockfall to reach roadway. Remedial actions are required, and should be developed and implemented following an expedited schedule.
B	<u>Moderate Risk</u> : Medium potential for rockfall to reach roadway. Remedial actions might be required, but implementation could possibly be extended over time to accommodate budgetary constraints.
C	<u>Low Risk</u> : Low potential for rockfall to reach roadway. Remedial actions may not be required, but inspection and monitoring of these slopes should continue.

For rock cut-slopes between MPs 17.30 and 18.06, it should be noted that rockfall hazard slope ratings could not be established because these slopes consist of a combination of soil slopes with rock fragments on the surface, cut slopes in talus rock masses, and/or historic rock block retaining structures, which have experienced varied degrees of distress.

However, Golder recommends that the slopes between MPs 17.30 and 18.06 be classified as “High Risk”, based on qualitative assessments of observed conditions, Golder’s experience with similar slope conditions and the fact that this section of the roadway has little to no shoulder lane.

POTENTIAL REMEDIAL DESIGN ALTERNATIVES

Over the course of the project, potential remedial actions for problem slopes were identified, and different methods were identified to mitigate degrees of risk associated with potential rockfall events. In general, these mitigation techniques can be divided into the following three (3) remedial design categories, which are as follows:

1. Rock Removal;
2. Rock Stabilization; and
3. Rockfall Control.

The following sections of this report provide brief descriptions for each of the above categories of rockfall hazard remedial design alternatives.

Rock Removal

Removal of loose or unstable blocks of rock or rock masses would require hand and/or machine scaling to remove loose rocks from crests and slope faces, trim blasting to remove larger rock masses that cannot be easily or safely hand/machine scaled, and/or reduction of slope angles to create rockfall catchment areas adjacent to the roadway.

Where rock removal is performed above active roadways, traffic controls and/or temporary rockfall control measures, where traffic controls cannot be implemented, would be required, as necessary, to protect the active roadway.

Brief descriptions of these rock-removal remedial design alternatives are as follows:

- **Hand Scaling:** The process of scaling by physically removing loose rocks from rock slope crests and/or faces by means of hand tools. Hand scaling is often done following blasting and over the life of a rock slope to mitigate risks associated with future rockfall events. The process of hand scaling usually entails trained personnel rappelling down or using crane/hoist baskets over slope faces to dislodge loose rocks from the face using steel pry bars and/or airbag jacks. Visual impacts and aesthetic effects of scaling tend to be limited. Scaling activities can be timed to reduce impacts on wildlife.
- **Machine Scaling:** The process of machine scaling, like hand scaling, involves removing loose rocks from rock slope crests and/or faces by means of heavy machinery, which could consist of large backhoes, cranes, backhoe mounted hoe-rams (percussion rams), and/or jack-hammers. However, the ability to use heavy machinery is often limited by equipment reach, access and the size of rock material to be removed. Visual impacts following scaling are as noted above for hand scaling. The use of trim blasting is often considered preferable to machine scaling, because the duration of noise and construction is reduced. As with hand scaling, scaling activities can be timed to reduce impacts on wildlife.
- **Trim Blasting:** Trim blasting is used to scale rock blocks or volumes of loose rock that are either too large for hand/machine scaling or are inaccessible to machinery. Trim blasting is also implemented to reduce construction durations. The process of trim blasting involves drilling parallel, drill holes, or pre-split-type holes and placement of small explosive charges behind loose rock blocks or rock masses to effect their scaling from rock slope crests and/or faces. Visual impacts following trim blasting are generally as noted for hand/machine scaling. Construction impacts include drilling noise, dust and blasting. Impacts to wildlife can be minimized by timing the construction. Typically, trim blasting is also followed by hand scaling activities.

- **Slope Angle Reduction:** Where bedding, joint or fracture orientations create potentially unstable rock blocks that are too large to remove using hand/machine scaling and/or trim blast, reducing the slope angle can be the preferred remedial design alternative, if it can be performed within right-of-way restrictions. The process of slope angle reduction involves laying the slope back to a more stable configuration or by creating new rockfall catchment areas. This alternative would entail rock excavation by blasting and reconstruction of ditches at the toes of slope. Visual impacts would include new slope geometries, which could potentially be noticeable by people familiar with the slope. Construction impacts would include equipment noise including rock drills, heavy equipment and blasting, and dust. Impacts to wildlife can be minimized by timing the construction.

Rock Stabilization

Rock stabilization involves securing potentially unstable rock blocks/masses by mechanical means such as rock bolting, buttressing, lashing and/or shotcreting. Rock blocks that are bounded by joint or bedding planes that are relatively tight can be bolted or pinned in place.

The installation of rock bolts and/or pins involves drilling multiple holes through the rock block and into the intact rock mass behind the block. Steel bolts consisting of reinforcing bars are inserted and grouted within the drilled holes. The bolts keep the joint surfaces in tight contact such that maximum friction along the joint surface is maintained and sliding is resisted. In general, rock bolting is not very effective on blocks that have already been displaced and have dilated joints.

Rock lashing involves installing bolts as rock anchors and stringing cables from the installed rock bolts across the blocks to lash them together. Rock lashing is effective for rocks that have dilated joints, which may have undergone some displacement.

Rock lashing, because it is generally conducted on isolated rock blocks rather than large areas of slopes, generally has limited visual impacts. The installation of bolts and lashing is accomplished with percussion drilling techniques. Impacts to wildlife can be minimized by timing the construction.

Buttressing involves constructing concrete props or buttresses to support potentially unstable blocks of rock and/or overhangs. This method of stabilization is not commonly used but it can provide a suitable solution in particular conditions.

Rockfall Control

Rockfall control involves the construction of barriers to catch, stop and/or direct/redirect the trajectory of falling rock blocks/masses. Catching falling rocks can be achieved by constructing rockfall catchment ditches or constructing barriers that would absorb the rocks' impact energy.

In general, catchment ditches at the toes of existing rock slopes within the assessment corridor are very small and in many cases non-existent. The efficiency of catch ditches can be improved by modifying the geometry of the ditch to increase the ditch width and depth, or constructing lips on the outside edge of the ditch such that rocks cannot climb or bounce over while falling.

Impact barriers, including walls or high impact fences, can be constructed along roadway shoulders. These impact barriers can also consist of concrete or timber walls, gabion walls, or cable net fences. Specific design details for such impact barriers depend on the heights needed and the impact energies likely to strike said barriers.

Impact barriers should be separated from the traveled lanes by guardrails or “Jersey” barrier. Post-construction impacts can be aesthetically acceptable. Construction impacts are generally confined to the area close to the roadways so impacts to wildlife should be minimal during construction.

Rockfall drape nets can be use to limit rockfall energies by controlling the rates of rockfall debris falling down slope and conveying said rockfall to designated catchment areas. Hence, rockfall drape nets allows the rock mass to ravel down slope and controls the outward bouncing motion of the rockfall debris, so that it is contained close to the toe of slope.

Steel wire mesh drape nets are generally used to control blocks smaller than 2 feet in nominal dimension. Post construction impacts are visual and can be mitigated, to some extent, by selecting materials (galvanized or coated) that blend with the surrounding rock mass colors. Construction impacts can be limited by scheduling.

In general, rockfall drape nets are constructed as free-hanging meshes supported along rock slope crests, and lengths of coverage depends on slope geometries and location and size of catchment ditches. In addition, drape nets can be supported above rock slope crest surfaces to allow rock blocks tumbling down slope, along back slopes, to be controlled by said drape nets.

RECOMMENDATIONS

As presented in Table 2, a total of seventeen (17) rock cut-slopes within the referenced project’s assessment corridor were inspected and evaluated to establish updated rockfall hazard slope ratings, and a summary of these rated rock cut-slopes is as follows:

- Five (5) slopes were rated to be “high-risk”, which require expedited remedial actions to mitigate risks associated with rockfall;
- Eight (8) slopes were rated to be “medium risk”, which might require remedial actions to mitigate risks associated with rockfall. However, needs for such remedial actions should be further evaluated based on continued, routine slope inspections. Hence, implementation of remedial actions for these slopes could possibly be extended over time; and
- Four (4) slopes were rated to be “low-risk”, which do not require remedial action at this time, but should be routinely re-inspected and re-evaluated to identify potential future rockfall hazard risks, if any.

Therefore, recommended rockfall hazard remedial design alternatives for the referenced project can be described by the following three (3) categories: a) Engineered Controls; b) Monitoring and Inspection; and c) Project Pipeline Assignments. The following sections of this report present Golder’s recommendations for each of these categories.

Engineered Controls

As previously mentioned, five (5) slopes were rated to be “high risk”, and require expedited remedial action to mitigate risks associated with rockfall. Hence, recommendations for each of these five (5) evaluated slopes are as follows:

- **MP-17.30 to MP-18.06:** Slopes within this area are composed of a combination of soil slopes with rock fragments on the surface, cut slopes in talus rock masses and/or historic rock block retaining structures, which have experienced varied degrees of distress.

The recommended remedial design alternative for this area will ultimately be dependent on whether NJDOT plans to realign and/or widen the roadway in this section of the assessment corridor to establish a full shoulder lane at the toe of the slope.

If NJDOT elects to demolish the existing historic rock block wall and cut further into the existing soil and talus rock slopes, the preferred remedial design alternative might involve excavating the entire talus rock mass and stabilizing the exposed rock face. However, the spatial extent and volume of this talus rock mass is not currently known.

Given uncertainty regarding the talus rock mass and NJDOT's future plans to realign/widen the roadway, Golder recommends, at this time, that this section of the assessment corridor be remedied by stabilizing the slope using either gravity (i.e., gabion or bin walls) or drilled soldier pile and pre-cast concrete lagging retaining wall systems.

In addition, Golder recommends that tops of these retaining walls be raised 5 feet (min.) above the toe of the adjacent back-slope to provide for a rockfall catchment area and prevent rockfall from the back-slope from traveling down slope and into the roadway corridor.

- **MP-27.40 to MP-27.50:** Slopes within this area are composed of grey siltstone and dark grey basalt intersected by numerous fractures dividing the rock mass into discrete rock blocks.

Golder recommends that this section of the assessment corridor be remedied by the following: a) clearing vegetation from the entire rock cut-slope face utilizing cutting techniques; b) hand scaling the entire rock cut-slope face; and c) installing rockfall drape nets over the entire rock cut-slope face.

- **MP-27.50 to MP-27.65:** Slopes within this area are composed of massively bedded dark grey fine-grained sedimentary rocks (i.e., mudstone or siltstone), which are intersected by both bedding and sub-vertical fracture planes.

Golder recommends that this section of the assessment corridor be remedied by the following: a) clearing vegetation from the entire rock cut-slope face utilizing cutting techniques; b) hand scaling the entire rock cut-slope face; c) installing rockfall drape nets over the entire rock cut-slope face; d) removing large, unstable rock blocks/masses from back-slope areas; and e) installing rockfall energy impact fences along cut-slope crests to prevent rockfall from tumbling down the back-slope and falling into the roadway.

- **MP-27.78 to MP-28.48:** Slopes within this area are composed of massively bedded to thinly laminated grey to red shale and siltstone rocks, which are intersected by both bedding and sub-vertical fracture planes and exhibit moderate to severe weathering.

Golder recommends that this section of the assessment corridor be remedied by the following: a) clearing vegetation from the entire rock cut-slope face utilizing cutting

techniques; b) hand scaling the entire rock cut-slope face; c) installing rockfall drape nets over the entire rock cut-slope face; d) removing large, unstable rock blocks/masses from back-slope areas; and e) installing rockfall energy impact fences along cut-slope crests to prevent rockfall from tumbling down the back-slope and falling into the roadway.

- **MP-29.85 to MP-30.45:** Slopes within this area are composed of massively bedded light to reddish-brown fine-grained sedimentary rocks (i.e., mudstone or siltstone), which are intersected by both bedding and sub-vertical fracture planes.

Golder recommends that this section of the assessment corridor be remedied by the following: a) clearing vegetation from the entire rock cut-slope face utilizing cutting techniques; b) hand scaling the entire rock cut-slope face; c) installing rockfall drape nets over the entire rock cut-slope face; d) removing large, unstable rock blocks/masses from back-slope areas; and e) installing rockfall energy impact fences along cut-slope crests to prevent rockfall from tumbling down the back-slope and falling into the roadway.

In addition, Golder recommends that NJDOT implement the above rockfall hazard remedial design alternatives utilizing a phased approach consisting of the following two (2) stages;

Stage I:

1. Clear vegetation from entire cut-slope;
2. Hand scale entire cut-slope; and
3. Remove large, unstable rock blocks/masses from back-slope areas.

Stage II:

1. After scaling, re-inspect, map and re-evaluate rock cut-slope to determine whether or not additional engineered controls (i.e., rock bolts/dowels, drape nets and impact fences) are required;
2. If additional engineering controls are required, define locations for all recommended engineered controls; and
3. Install the recommended engineered solutions in accordance with the technical specifications provided in the Contract Documents.

It is Golder's opinion that the above phased approach should provide NJDOT with adequate controls on project costs by providing engineered controls in areas that warrant such remedial measures. Hence, Golder recommends that NJDOT consider "unit price" contracting options for installing specified engineered controls.

Monitoring and Inspection

Regardless of whether engineered controls are implemented, Golder recommends that each of the evaluated slopes within the assessment corridor be re-inspected and re-evaluated on a routine, continual basis to document changes in slope conditions and identify potential future rockfall hazard risks, if any.

However, periods between re-inspections would likely not be uniform, and depend on previously established rockfall hazard slope ratings. See Table 4 for Golder's recommended monitoring and inspection periods for each rockfall hazard slope rating classification:

Table 4 – Recommended Monitoring and Inspection Periods

Slope Rating	Description	Monitoring and Inspection Period
A	<i>High Risk</i>	Annually (min.), or more frequent
B	<i>Moderate Risk</i>	Once every year, or as established by NJDOT
C	<i>Low Risk</i>	Once every two (2) years, or as established by NJDOT

Ultimately, NJDOT would be responsible for scheduling future rock slope inspections and evaluations, and Golder understands NJDOT would either utilize “in-house” personnel or elect to use external engineering design consultants to undertake and complete this work on a continual basis.

Project Pipeline Assignments

NJDOT has established a project delivery process allowing for all projects to be advanced from feasibility study through design and into construction, and this process is comprised of four (4) project pipelines, which can be summarized as follows:

Project Pipeline	Description
1	Complex projects requiring feasibility assessments; preliminary and final design submissions; and preparation of contract documents and engineer cost estimates.
2	Moderate projects requiring some involvement with Right-of-Way, utilities and/or environmental permits.
3	Moderate to simple projects having clearly defined Scopes-of-Work and minimal involvement with Right-of-Way, utility and/or environmental permits.
4	Simple projects requiring no involvement with Right-of-Way and minimal or no involvement with utility and/or environmental permit. In addition, these projects would be managed by NJDOT Operations.

With exception of the slopes between mileposts MP-17.3 to MP-18.06, it is Golder’s opinion that the recommended rockfall hazard remedial design alternatives represent moderate to simple degrees of difficulty. However, it should be noted that, at this time, the degree of involvement with respect to Right-of-Way, utility and environmental permits are not clearly defined.

Therefore, based on the above descriptions, Golder recommends the following project pipelines for each of the designated “high risk” rock slopes and for each work phase:

Mileposts		Work Phase	Work Description	Project Pipeline
Start	End			
17.30	18.06	n/a	n/a	1
27.40	27.50	I	Clear Vegetation/Rock Scaling	4
		II	Engineered Controls	3
27.50	27.65	I	Clear Vegetation/Rock Scaling	4
		II	Engineered Controls	3
27.78	28.48	I	Clear Vegetation/Rock Scaling	4
		II	Engineered Controls	3
29.85	30.45	I	Clear Vegetation/Rock Scaling	4
		II	Engineered Controls	3

PRELIMINARY CONSTRUCTION COSTS

For planning purposes, NJDOT requested that Golder develop conceptual-level, preliminary construction cost estimates for its recommended rockfall hazard remedial design alternatives. Hence, preliminary opinions of potential construction costs were prepared for only those rock cut-slopes designated as "high risk". See Table 2.

See Table 5 for the referenced project's preliminary construction costs to implement the recommended remedial design alternatives for each of the five (5) designated "high risk" rock cut-slopes. Furthermore, these construction costs have been broken down to show cost components associated with each of the "high risk" rock cut-slopes.

Given the nature and high degree of uncertainty associated with the referenced project, Golder recommends these conceptual-level, preliminary construction cost estimates utilize contingency factors of 40%. Overall, the total estimated construction cost to implement the recommended remedial design alternatives is about \$19,452,000 (see Table 5).

However, it should be noted that the costs presented in Table 5 do not include requisite design, inspection, construction management/oversight and/or long-term maintenance costs. In addition, these costs assume that the recommended remedial design alternatives would be aesthetically acceptable to NJDOT and the local community.

Long-term maintenance will be required to maintain the recommended remedial design alternatives, and maintenance activities could include, but would not be limited to, the following: a) removal of rock debris at bases of rock cut-slopes; b) repair/replacement of damaged drape nets and/or impact barriers; c) removal of rock debris collected in the installed rockfall impact barriers; and d) clearing of vegetation cover re-growth.

REFERENCES

1. NJDOT, Geotechnical Engineering Unit, Original 1988 Rockfall Mitigation Program, Phase 1, Preliminary Ratings and Methodology.
2. NJDOT, Geotechnical Engineering Unit, Original 1989 Rockfall Mitigation Program, Phase 2, Detailed Ratings and Methodology.
3. NJDOT, Geotechnical Engineering Unit, Comments/Modifications to Reference #6.
4. NJDOT, Updated/Current Preliminary Ratings and Legend, prepared using a modified version of the methodology described in Reference #6.
5. NJDOT, Updated Detailed Ratings, prepared using a modified version of Reference #6.
6. Federal Highway Administration (FHWA), Publication No. FHWA-OR-EG-90-01, entitled "Rockfall Hazard Rating System – Implementation Manual", 1990.
7. FHWA, Publication No. FHWA-SA-93-057, entitled "Rockfall Hazard Rating System – Participant's Manual", 1993.

8. FHWA, Publication No. FHWA SA-93-085, entitled "Rockfall Hazard Mitigation Methods – Participant Workbook", 1994.
9. Hoek E. and Bray, J. W., Rock Slope Engineering, Institution of Mining and Metallurgy, London, 1981.

LIMITATIONS

This report was prepared for the exclusive use of RBA and NJDOT for specific applications on the referenced project, in accordance with generally accepted geotechnical engineering practices.

Recommendations contained herein only represent preliminary, conceptual-level rockfall hazard remedial design alternatives, and should not be misconstrued to represent final design recommendations.

Golder assumes that the referenced project's final design would be undertaken and completed by others, and final designs should include, but not be limited to, the following: establish limits of work; define scope and extent of engineered solutions; prepare appropriate contract documents; and establish final engineers' cost estimates.

Recommendations contained herein were based on Golder's current understanding of the referenced project, which is that NJDOT does not intend or plan to realign and/or widen Route 29 through the assessment corridor.

Any realignment or widening of Route 29 through the assessment corridor would directly impact the rockfall hazard slope ratings and remedial design alternatives presented herein. Hence, the recommendations presented herein should be reassessed, if NJDOT elects to consider any realignment and/or widening options.

Recommendations included herein assume that the overall rockfall hazard mitigation program will be visual and aesthetically accepted by NJDOT and the local community. If alternate remedies are required to satisfy more stringent visual and/or aesthetic design criteria, the recommendations and preliminary construction costs presented should be revised accordingly.

Recommendations included herein are contingent upon one another, and no recommendation should be followed independent of others. In addition, Golder's recommendations should be incorporated in the future construction drawings and technical specifications prepared by others.

This report provides no warranties expressed or implied. In addition, Golder cannot be held responsible for claims, damages or liability arising from interpretations or reuse of subsurface information collected and provided by others.

If changes to the nature and/or design of the referenced project are planned, the conclusions and recommendations contained herein should not be construed to be valid, unless said changes are reviewed and associated conclusions modified or verified by Golder in writing.

Furthermore, if design of the recommended remedial measures at "high risk" sections are deferred for more than one (1) year, said associated slopes should be re-inspected, re-evaluated at the frequency recommended in Table 4 herein to determine whether or not slope conditions have changed and require different remedial design approaches.

CLOSURE

Golder is pleased to have had the opportunity to prepare this **Remedial Design Alternatives Report** for RBA, and looks forward to continued participation on the referenced project. If you have any questions, please feel free to contact either of the undersigned at (973) 621-0777.

Very truly yours,

GOLDER ASSOCIATES INC.

Mark F. McNeilly, P.E.
Senior Consultant and Associate

DRAFT

Robert E. Stetkar, P.E.
Practice Leader and Principal

Attachments
C.c.: R. Cross